

WASHINGTON
N 94
11/11/83

MISSISSIPPI DEPARTMENT OF NATURAL RESOURCES
Bureau of Land and Water Resources
Southport Mall
P.O. Box 10631
Jackson, Mississippi 39209
WATER WELL DRILLERS LOG

CODED

11-11-1983 Schultz Drilling Washington
date well completed firm name county well located

LANDOWNER: C. G. Steele
Longwood Farms
Greenville MS
(mailing address)

description of formations encountered	from	to
Clay	0	28
COARSE SAND	28	40
COARSE SAND + pea gravel	40	60
COARSE SAND + pea gravel ; gravel	60	85
	85	100

WELL LOCATION:
sec. 11 T. 15 N R. 8 E
4 miles West of Holbrook
(distance) (direction) (nearest town)

WELL PURPOSE: IRRIGATION
(home, irrigation, municipal, industrial)

- WELL COMPLETION DATA:
- (1) diameter (inches) 10"
 - (2) total depth (feet) 100'
 - (3) static water level (feet) 28' below top of ground.
 - (4) casing PVC 60'
(material) (depth)
 - (size) if telescope see back.
 - (5) screen 40' 60'
(length) (depth to top)
 - 10" PVC
(size) (material)
 - (6) pump none approx. 1000
(HP) (yield gpm)
 - none
(type power)
 - (7) electric log NO
(yes or no)
 - NO
(organization running log)
 - (8) how well bottom plugged PVC cap

CODED

DEPT. OF NATURAL RESOURCES
BUREAU OF LAND & WATER RESOURCES


NOV 23 1983

DRILLERS REMARKS:

RECEIVED

If well telescopes please sketch and show depths.

GROUND LEVEL

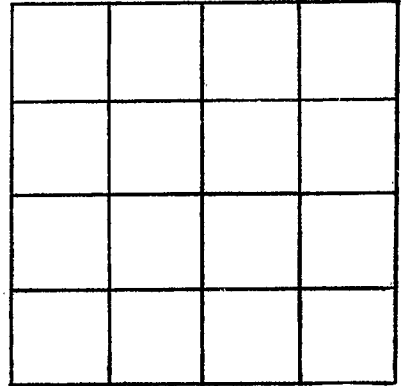

SECTION _____

Please indicate well location X.

ADDITIONAL INFORMATION

If more than one screen,
show locations of each on sketch.