

MISSISSIPPI DEPARTMENT OF NATURAL RESOURCES

Bureau of Land and Water Resources

Southport Mall

P.O. Box 10631

Jackson, Mississippi 39209

WATER WELL DRILLERS LOG

CODED

WASHINGTON
N101

5-20 1985 Scheltz Drilling Washington
date well completed firm name county well located

LANDOWNER:
Leo Williams
Hollandale MS
(mailing address)

description of formations encountered	from	to
CLAY SAND	0	31
	31	93

WELL LOCATION:
sec. B-T 15^N R-8^E
3 miles W of Hollandale
(distance) (direction) (nearest town)

WELL PURPOSE: IRRIGATION
(home, irrigation, municipal, industrial)

CODED

- WELL COMPLETION DATA:
- (1) diameter (inches) 8"
 - (2) total depth (feet) 93'
 - (3) static water level (feet) 35' below top of ground
 - (4) casing PVC, 63' (material) (depth)
 - (size) if telescope see back.
 - (5) screen 20' 63' (length) (depth to top)
 - 8" PVC (size) (material)
 - (6) pump 10 500 (HP) (yield gpm)
 - ele (type power)
 - (7) electric log NO (yes or no)
 - (organization running log) X
 - (8) how well bottom plugged CAP


RECEIVED

DFG 3 - 1985

DRILLERS REMARKS:

If well telescopes please sketch and show depths.

GROUND LEVEL

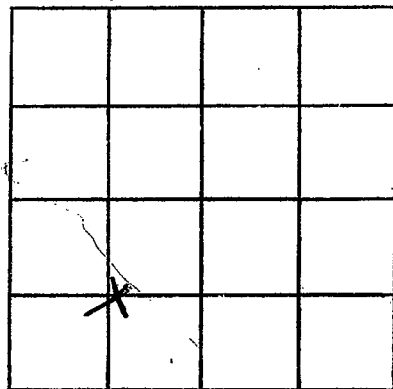

SECTION 13

Please indicate well location X.

ADDITIONAL INFORMATION

If more than one screen, show locations of each on sketch.