

MISSISSIPPI DEPARTMENT OF NATURAL RESOURCES

Bureau of Land and Water Resources

Southport Mall

P.O. Box 10631

Jackson, Mississippi 39209

WATER WELL DRILLERS LOG

WASH 1000  
N 102

CODED

5-27-88 date well completed  
Schultz Drilling firm name  
Washington county well located


LANDOWNER: Earnest Currey  
Box 235  
Hollandale, MS 38748  
(mailing address)

description of formations encountered	from	to
CLAY	0	14
FINE SAND	14	50
COARSE SAND	50	105
SAND + pea gravel	105	130

WELL LOCATION:  
sec. 12 T. 15 N. R. 8 E  
6 miles W of Hollandale  
(distance) (direction) (nearest town)

WELL PURPOSE: IRRIGATION  
(home, irrigation, municipal, industrial)

- WELL COMPLETION DATA:
- (1) diameter (inches) 16"
  - (2) total depth (feet) 130'
  - (3) static water level (feet) 32' below above top of ground.
  - (4) casing PVC 90'  
(material) (depth)
  - (5) screen 40' 90'  
16" (length) (depth to top)  
(size) (material) PVC
  - (6) pump 50 3000  
(HP) (yield gpm)  
GEAR  
(type power)
  - (7) electric log NO  
(yes or no)  
(organization running log) Y
  - (8) how well bottom plugged LAP

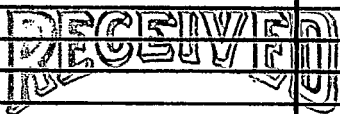


JUN 16 1988

Department of Natural Resources  
Bureau of Land & Water Resources

DRILLERS REMARKS:

If well telescopes please sketch and show depths.

GROUND LEVEL

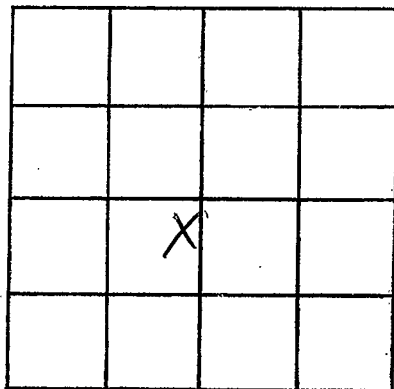

SECTION 12

Please indicate well location X.

ADDITIONAL INFORMATION

If more than one screen,  
show locations of each on sketch.