




If well telescopes please sketch and show depths.

GROUND LEVEL

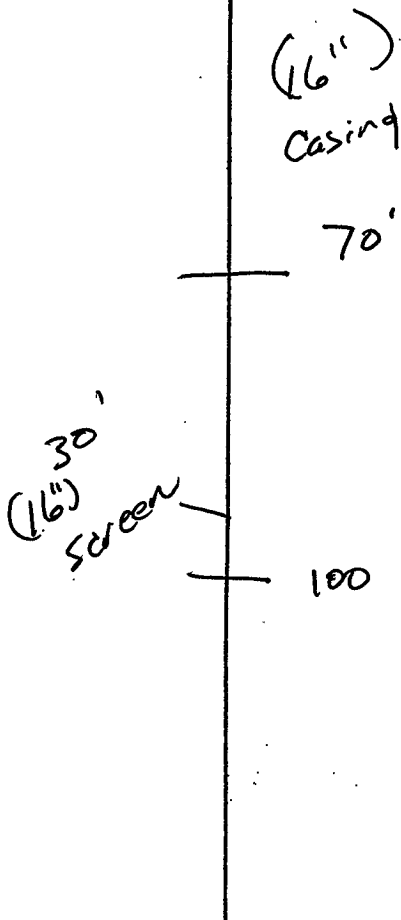

If more than one screen, show location of each on sketch.

	X		

SECTION 22

Please indicate well location X.

Pump Capacity (GPM)	No. of Stages	Setting Depth
1800	2	60 FT.

PUMP TEST

Well yielded \_\_\_\_\_ GPM with a drawdown of \_\_\_\_\_ ft. after \_\_\_\_\_ hours of pumping

LOG DATA

TYPE OF LOG RUN (Circle One):  No Log Run, Electric, Gamma Ray, Density, Sonic, Neutron, Other (Describe) \_\_\_\_\_

Name of Organization Running Log

GEOLOGIC DATA (Office Use Only)

Surface Elev.	Geologic Unit	Unit Thickness	Depth to Top
Subs. SWL	Date	Analysis	Aquifer Test

Driller's Remarks

\_\_\_\_\_

\_\_\_\_\_

