	State Well Report	
_{County:} Washington	Part 1	For Office Use Only:
	Mississippi Department of Environmental Quality	
Permit#: <u>GW41538</u> Irrigation Equipment Driller:	Office of Land and Water Resources P.O. Box 10631	Well #: <u>N-134</u>
Date drilling completed: $2-22-07$	Jackson, MS 39289-0631	L. S. Elevation:
Date drilling completed:	(601)961-5210 (601)354-6938 (fax)	E-log #:
State Law requires that this repo 30 days of completion of drilling		
Well Owner Informa	ation W	ell Location
Owner NameJ. Wade Quint	nLatitude:	U4_20,91
Mailing Address: 3007 Prospe	erity Drive Method of Lat/Long (circle	9N 91 04 26, 9V "Longitude: one): Conventional Survey, 2
	USGS quad, Hand-he	ld GPS, Survey-grade GPS
Tone-l-		& Twn 15N 18 81
Jonesboro	$\frac{AR}{R} \frac{72404}{R} \frac{2}{R} \frac{4}{R} \frac{2}{R} \frac{4}{R} \frac{8}{R} \frac{1}{R} \frac{1}{R}$	$\frac{\vartheta}{3} \operatorname{Twn} \frac{15N}{9W} \frac{\kappa_{\mathrm{Rng}}}{9W}$
City Stat	te Zip Code Distance Direction	Nearest Town of Longwood
Telephone No. ()		
· · · · · · · · · · · · · · · · · · ·	Well Data	
Purpose of Well (circle one) Home Inde	Pivot	Other:
Date well drilling started: $2-22-$	07 Date well drilling completed: _2-	22-07
	0 / Date well drilling completed: _2_ lve Other (describe)	
If flowing, method of flow regulation: Val		
If flowing, method of flow regulation: Val	lve Other (describe) ove or below (circle one) land surface Date measured	
If flowing, method of flow regulation: Val Static Water Level: <u>27'</u> feet ab Method of Measurement (circle one)	lve Other (describe) ove or below (circle one) land surface Date measured	<u></u>
If flowing, method of flow regulation: Val Static Water Level: <u>27'</u> feet ab Method of Measurement (circle one)	ver Other (describe) nove or below (circle one) land surface Date measured reel take electric tape air line other:	<u>8-7-07</u>
If flowing, method of flow regulation: Val Static Water Level: <u>27'</u> feet ab Method of Measurement (circle one) Hole depth: <u>129</u> Well dep Type of grout (circle one): Cement Casing length: <u>69</u> feet Casing	Ive Other (describe) pove or below (circle one) land surface Date measured pove or be	10feet
If flowing, method of flow regulation: Val Static Water Level: 27' feet ab Method of Measurement (circle one) 4 Hole depth: 129 Well dep Type of grout (circle one): Cement	Ive Other (describe) pove or below (circle one) land surface Date measured pove or be	10fcet
If flowing, method of flow regulation: Val Static Water Level: <u>27'</u> feet ab Method of Measurement (circle one) Hole depth: <u>129</u> Well dep Type of grout (circle one): Cement Casing length: <u>69</u> feet Casin	Ive Other (describe) pove or below (circle one) land surface Date measured pove or be	<u>10</u> <u>feet</u> PVC Sch.40 PVC Sch.40
If flowing, method of flow regulation: Val Static Water Level: 27' feet ab Method of Measurement (circle one) 4 Hole depth: 129 Well dep Type of grout (circle one): Cement Casing length: 69 feet Casing Screen length: 60 feet Screen	Ive Other (describe) pove or below (circle one) land surface Date measured cel take electric tape air line other: cel take electric tape air line other: poth: 129 Well grouted to a depth of bentonic Mix ng diameter: 16 inches en diameter: 16 inches Type of screen: Setting depth: From70 feet to1	<u>10</u> <u>10</u> <u>feet</u> <u>PVC Sch.40</u> <u>PVC Sch.40</u> <u>29</u> <u>feet</u>
If flowing, method of flow regulation: Val Static Water Level: 27' feet ab Method of Measurement (circle one) 4 Hole depth: 129 Well dep Type of grout (circle one): Cement Casing length: 69 feet Screen Screen length: 60 feet Screen Screen slot size: 050 inches	Ive Other (describe) pove or below (circle one) land surface Date measured pove or below (circle one) land surface Date measured peel take electric tape air line other: peel take electric tape air line other: peth: 129 Well grouted to a depth of bentonic Mix ng diameter: 16 inches en diameter: 16 inches Type of screen: Setting depth: From 70 feet to 1 Gravel packed Underreamed Telescoped Option	10 feet PVC Sch.40 PVC Sch.40 29 feet sn hole Natural Development
If flowing, method of flow regulation: Val Static Water Level: 27' feet ab Method of Measurement (circle one) 4 Hole depth: 129 Well dep Type of grout (circle one): Cement Casing length: 69 feet Casin Screen length: 60 feet Screet Screen slot size: 050 inches Type of completion (circle all applicable):	Ive Other (describe) pove or below (circle one) land surface Date measured neel take electric tape air line other: path: 129 Well grouted to a depth of bentonice Mix ng diameter: 16 inches Type of casing: en diameter: 16 inches Type of screen: Setting depth: From 70 feet to 1 Gavel packed Underreamed Telescoped Ope Other (describe): Ope Ope	10 feet 10 feet PVC Sch. 40 PVC Sch. 40 29 feet en hole Natural Development
If flowing, method of flow regulation: Val Static Water Level: <u>27'</u> feet ab Method of Measurement (circle one) Hole depth: <u>129</u> Well dep Type of grout (circle one): Cement Casing length: <u>69</u> feet Casin Screen length: <u>60</u> feet Scree Screen slot size: <u>050</u> inches Type of completion (circle all applicable): Top of lap pipe or reduction in casing:	Ive Other (describe) pove or below (circle one) land surface Date measured peel take electric tape air line other: peth:129 Well grouted to a depth of pent:16 inches Type of casing: en diameter:16 inches Type of screen: Setting depth: From70 feet to1 Gravel packed Underreamed Telescoped Other (describe):	:: 3-7-07 10 feet PVC Sch.40 PVC Sch.40 29 feet zn hole Natural Development creen, describe on back of page
If flowing, method of flow regulation: Val Static Water Level: <u>27'</u> feet ab Method of Measurement (circle one) Hole depth: <u>129</u> Well dep Type of grout (circle one): Cement Casing length: <u>69</u> feet Casin Screen length: <u>60</u> feet Scree Screen slot size: <u>050</u> inches Type of completion (circle all applicable): Top of lap pipe or reduction in casing:	Ive Other (describe) pove or below (circle one) land surface Date measured neel take electric tape air line other: path: 129 Well grouted to a depth of bentonice Mix ng diameter: 16 inches Type of casing: en diameter: 16 inches Type of screen: Setting depth: From 70 feet to 1 Gavel packed Underreamed Telescoped Ope Other (describe): Ope Ope	:: 3-7-07 10 feet PVC Sch.40 PVC Sch.40 29 feet zn hole Natural Development creen, describe on back of page
If flowing, method of flow regulation: Val Static Water Level: <u>27'</u> feet ab Method of Measurement (circle one) Hole depth: <u>129</u> Well dep Type of grout (circle one): Cement Casing length: <u>69</u> feet Casin Screen length: <u>60</u> feet Scree Screen slot size: <u>050</u> inches Type of completion (circle all applicable): Top of lap pipe or reduction in casing: Logs run (circle all applicable): No log run Name of organization running log(s):	IveOther (describe) powe or below (circle one) land surface Date measured cel take electric tape air line other: cel take electric tape air line other: pth:129 Well grouted to a depth of memory Mix ng diameter:16 inches Type of casing: en diameter:16 inches Type of screen: Setting depth: From70 feet to1 Gravel packed Underreamed Telescoped Other (describe):	:: 3-7-07 10 feet PVC Sch.40 PVC Sch.40 29 feet m hole Natural Development creen, describe on back of page Other:
If flowing, method of flow regulation: Val Static Water Level: 27' feet ab Method of Measurement (circle one) for Hole depth: 129 Well dep Type of grout (circle one): Cement Casing length: 69 feet Casin Screen length: 60 feet Scree Screen slot size: 050 inches Type of completion (circle all applicable): Top of lap pipe or reduction in casing: Logs run (circle all applicable): 10 log run Name of organization running log(s): I certify that the well was drilled, constru	IveOther (describe) pove or below (circle one) land surface Date measured peel take electric tape air line other: peel take Mix mix mix mix ng diameter: 16 inches Type of casing: en diameter: 16 inches Type of screen: Setting depth: From 70 feet to 1 Gravel packed Underreamed Telescoped Ope Other (describe):	:: 3-7-07 10 feet PVC Sch.40 PVC Sch.40 29 feet en hole Natural Development creeen, describe on back of page Other:
If flowing, method of flow regulation: Val Static Water Level: 27' feet ab Method of Measurement (circle one) Hole depth: 129 Well dep Type of grout (circle one): Cement Casing length: 69 feet Casin Screen length: 60 feet Scree Screen slot size: 050 inches Type of completion (circle all applicable): Top of lap pipe or reduction in casing: Logs run (circle all applicable): Vo log run Name of organization running log(s): I certify that the well was drilled, constru Department of Environmental Quality and	IveOther (describe) powe or below (circle one) land surface Date measured cel take electric tape air line other: cel take electric tape air line other: pth:129 Well grouted to a depth of memory Mix ng diameter:16 inches Type of casing: en diameter:16 inches Type of screen: Setting depth: From70 feet to1 Gravel packed Underreamed Telescoped Other (describe): feet. If telescoped or more than one see an Electric Gamma Ray Density Sonic Neutron ucted, and completed in accordance with all applicab md/or the Mississippi Department of Health regulation	: 3-7-07 10 feet PVC Sch.40 PVC Sch.40 29 feet en hole Natural Development creeen, describe on back of page Other:
If flowing, method of flow regulation: Val Static Water Level: 27' feet ab Method of Measurement (circle one) for Hole depth: 129 Well dep Type of grout (circle one): Cement Casing length: 69 feet Casin Screen length: 60 feet Scree Screen slot size: 050 inches Type of completion (circle all applicable): Top of lap pipe or reduction in casing: Logs run (circle all applicable): 10 log run Name of organization running log(s): I certify that the well was drilled, constru	IveOther (describe) powe or below (circle one) land surface Date measured cel take electric tape air line other: cel take electric tape air line other: pth:129 Well grouted to a depth of memory Mix ng diameter:16 inches Type of casing: en diameter:16 inches Type of screen: Setting depth: From70 feet to1 Gravel packed Underreamed Telescoped Other (describe): feet. If telescoped or more than one see an Electric Gamma Ray Density Sonic Neutron ucted, and completed in accordance with all applicab md/or the Mississippi Department of Health regulation	:: 3-7-07 10 feet PVC Sch.40 PVC Sch.40 29 feet en hole Natural Development creeen, describe on back of page Other:

RECEIVED MAR 1 2 2007 BY: OLWR If well telescopes please sketch below and show depths.


Ground Level

Description of Formations Encountered	From	То
Clav	0	20
Fine Sand Fine Sand/gravel Med. Sand/gravel	21	35
Fine Sand/gravel	36	65
Med. Sand/gravel	66	127
Clay	128	129
	<u> </u>	
		ļ
	ļ	
		ļ
		L
		ļ

N-

If more than one screen, show location of each on sketch

Signature of Water Well Contractor

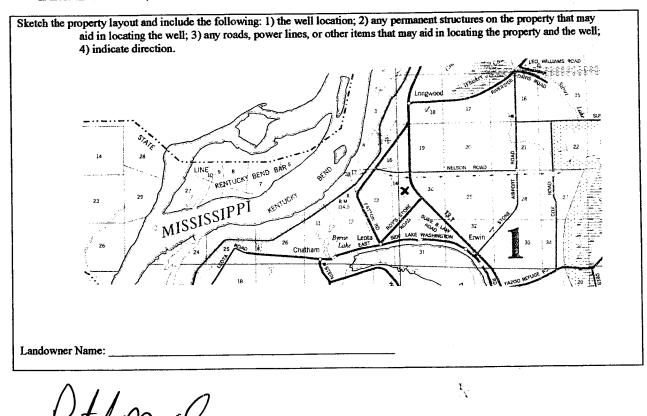

County: Washington	Part 2 Pump Installer's Completion Report	For Office Use Only:
ermit #:	Mississippi Department of Environmental Quality Office of Land and Water Resources	Aquifer:
rrigation Equipment	P.O. Box 10631	1- 121
tate completed:2-22-07	Jackson, MS 39289-0631 (601)961-5210 (601)354-6938 (fax)	Well #:

• •

петананы	tor pump.				
	Well Owner Inform	nation	1	Well Location	······································
Owner Name:	J. Wade Q	uinn	Latitude:	Longitude:	
Mailing Address	: <u>3007 Pro</u> :	<u>sperity D</u> rive	Method of Lat/I	ong (circle one): Conventio	onal Survey,
Telephone No. (Jonesborg		¹ 4 Distance	S quad, Hand-held GPS, S <u>4 Sec 30</u> Twn 15 Direction Nearest 1 South of Longwo	5N _{Rng} 8W
	Pump Type				······
	Circle one			Power Type Circle one	
Air Lift	Jet	Submersible	Incsel Engine	Gasoline Engine	Natural Gas
Bucket	Piston	Turbine	Electric Motor	Hand	Tractor PTO

Bucket	Piston	Turbine	Electric Motor	Hand	Tractor PTO
Centrifugal	Rotary	Flowing Well	Windmill	Other (specify):	
Other (specify):			Horse Power Rating	g of Motor: 60	
Date Pump Installed:	3	-7-07	Setting Depth:	60	feet
Rated Pump Capacity:	1400	Gallons Per Minute	Number of Stages:	3	

Date Well Tested:	Method of Measuring Water Level Circle one	
Static Water Level (A):Feet Below Land Surface Pumping Water Level (B):Feet Below Land Surface	Air Line Electric Measuring Line Steel Tape Other (specify):	
Drawdown [(B) – (A)]:Feet Below Land Surface	For flowing well, measured shut in head: feet	
Test Pumping Rate:Gallons Per Minute	Well yielded GPM with a drawdown of	
Duration of Pump Test (minimum 4 hours):hours	feet afterhours of pumping	

I HEREBY CERTIFY that the above statements are true to the be	est of my knowledge/	
Patrick M. Chism 0695	Patul M C	
Print Name of Pump Installer and License No. (if applicable)	Signature of Pump Installer	
		RECEIVED

MAR 1 2 2007 · BY: OLWR