
LAKeland	P1+.
	For Office Use Only:
County: NADHMATION Mississinni Department	f Environmental Quality Aquifer
Permit #: Office of Land an	Well #: 143
Driller. J. NEWCOME U-113 Jackson, MS	5 39289-0631 L.S. Elevation:
Date drilling completed: <u>6~18~09</u> (601)9 (601)354	61-5210 -6938 (fax) E-log #:
State Law requires that this report be prepared by the	
30 days of completion of drilling of the well. Well Owner Information	Well Location
Owner Name Lakelound Planting	Latitude: 33 . 09 . 44 " Longitude: 91 . 01 ' 14 "
Mailing Address: 96 Leo Williams Rd	Method of Lat/Long (circle one): Conventional Survey,
	USGS quad, Hand-held GPS Survey-grade GPS
Hollandale MS 38748	NE 14 SE 14 Sec_9_Twn_15N Rng BW
City State Zip Code	Distance Direction Nearest Town 10 Miles WEST of HOLLANDALE
Telephone No. ()	
Well	Data
Purpose of Well (circle one) Home Industrial Public Supply	Irrigation Fish Culture Other:
Date well drilling started: 6 - 18 - 09 Date	well drilling completed: 6-18-09
If flowing method of flow regulation: Valve Other	(describe)
Static Water Level:feet above or below (circle one	) land surface Date measured:
Method of Measurement (circle one) steel tape electric ta	pe air line other:
Hole depth: well deput	Well grouted to a depth of feet
Type of grout (circle one): Cement Bentonite M	inches Type of casing: $\underline{PVC}$
Casing length: 60 feet Casing diameter: 16	
Screen length: <u>40</u> feet Screen diameter: <u>16</u>	
Screen slot size: 050 inches Setting depth: From	
Type of completion (circle all applicable): Gravel packets Un	
	1 the mean of page
Top of lap pipe or reduction in casing:feet.	If telescoped or more than one screen, describe on back of page
	Ray Density Sonic Neutron Other:
Name of organization running log(s): I certify that the well was drilled, constructed, and completed	I in accordance with all applicable requirements of the Mississippi.
Department of Environmental Quality and/or the Mississipp	Department of Health regulations and state laws.
TH N-773	Ad Densen 3
JOHN NEWCOME 0-173 Print Name of Water Well Contractor and License No.	Signature of Water Well Contractor
FTEL NAME OF WARE WEI CONTACT AND LOOMO THE	RECEIVED
Replacement for GU13	SIT ? JUL 3 0 2009
· · · · · · · · · · · · · · · · · · ·	BY: OLWR

If well telescopes please sketch below and show depths.

NIAS



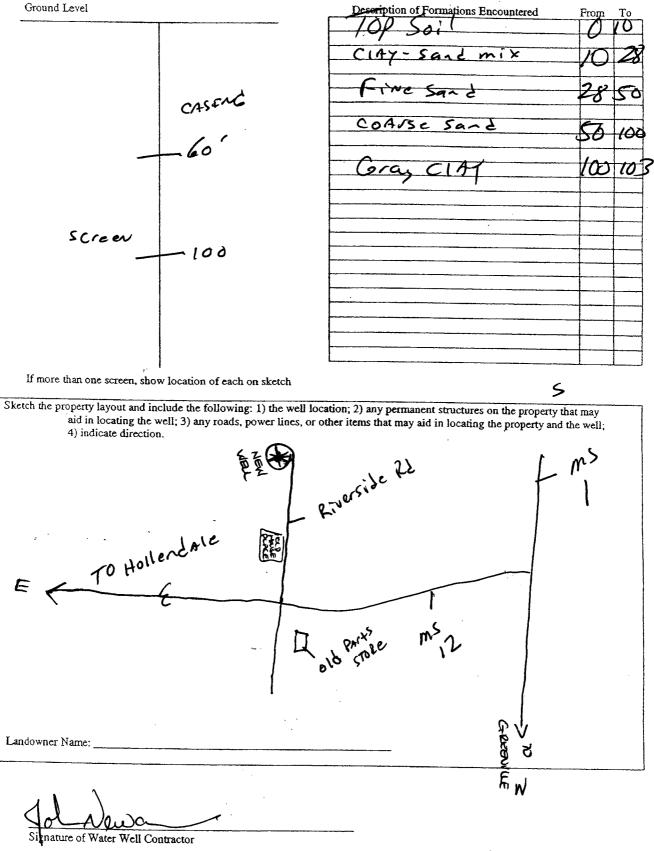

	7	ELL REPORT	
County: Washinton Permit #:	Part 2 Pump Installer's Completion Report Mississippi Department of Environmental Quality Office of Land and Water Resources P.O. Box 10631 Jackson, MS 39289-0631 (601)961-5210 (601)354-6938 (fax)		For Office Use Only:
Date completed: 0118/09			Well #: <u>NIAS</u> Elevation:
This report should be prepared by a installation of pump.	the pump installer in deta	il and filed with the Departme	ent within 30 days of the
Well Owner Inform	Planning Illians Rd	Latitude: 33° 09' 44 Method of Lat/Long (circle o USGS quad Han	d-held GPS. Survey-grade GPS
City State	Zip Code	Distance Direction	9 Twn ISN Rng 8W Nearest Town of HOllandale
Pump Type Circle one			ower Type Circle one
Air Lift Jet	Submersible		ine Engine Naturai Gas
Bucket Piston	Turbine	Electric Motor Hand	
Centrifugal Rotary	Flowing Well		(specify):
Other (specify):	·	Horse Power Rating of Moto	<u>r 40</u>
Date Pump Installed: 6180	9	Setting Depth:	feet
Rated Pump Capacity:	Gallons Per Minute	Number of Stages:	1
Pump Test Dat			easuring Water Level Circle one
Static Water Level (A):Fe			asuring Line Steel Tape
	et Below Land Surface	Other (specify):	
$\sum_{i=1}^{n} a_{i} a_{i}$	et Below Land Surface		shut in head:feet
Test Pumping Rece SH	Gallon Per Minute	Well yielded	GPM with a drawdown of
Duration of Pump Test (minimum 4 hour	s):bours	feet after	hours of pumping
I HEREBY CERTIFY that the above star CONFROME Print Name of Hump Installer and Licens	911-0	of my knowledge.	
			RECE
			JUL 3

1