

, XAN #-	7	
County: WASHINGTON Permit #: $GW - 47029$ Driller: J. NEWCOME 0.773 Date drilling completed: 3:14.13 Part 1 - I Mississippi Departmen Office of Land a P.O. Jackson (601)	Vell Report Driller's Log ht of Environmental Quality nd Water Resources Box 2309 h, MS 39225 961- 5210 1- 5228 (fax)	For Office Use Only: Aquifer:
State Law requires that this report be prepared by the lice Department at the above address within 30 days of comp Information on Well Owner (Landowner if borehole is not for a water well) Owner Name Hurr RIGER PLANTING (IMPANY Mailing Address: 65 Holly RIGER ROAD <u>FNDRANOLA MS 38751</u> City State Zip Code	Detion of drilling of the well Well or Bo Latitude: 33 • 06 • 30 Method of Lat/Long (circle or USGS quad, Hand-held IR ¼ IR ¼ Sec_13	the work and filed with the <u>or borehole.</u> prehole Location <u>" Longitude: 91 ° 07 , 42 "</u> ne): Conventional Survey, GPS, Survey-grade GPS <u>Twn_15N_Rng_09W</u>
Telephone No. ()	Distance Direction	of <u>CHATHAM</u>
Date drilling started: 3.14.13 Date drilling completed: 3.4.13		214
Location of the source of any surface water used for drilling: Dit Method of dosing and volume of Chlorine used in drilling and devel Logs run (circle all applicable) No log run Electric Gamma Ray Name of organization running log(s): Purpose of borehole (check one): Water Well Geotechnical/Geole Seismic Survey Other (describe If drilling is not related to water well construction	opment: <u>CN-ORINE</u> Density Sonic Neutron ogical Investigation Ground	Other:
Purpose of Well (check one): Home Industrial Public Supply If a flowing well, method of flow regulation: Valve O Static Water Level: feet above or below (circle one) 1	ther (describe)	
Method of Measurement (circle one) steel tape electric tape Well depth: <u>120</u> Well grouted to a depth of <u>10</u> feet Type Casing length: <u>90</u> feet Casing diameter: <u>16</u> Screen length: <u>30</u> feet Screen diameter: <u>16</u> Screen slot size: <u>.050</u> inches Setting depth: From _	air line other: of grout (circle one): Neat Cem inches Type of casing: 7 inches Type of screen: feet to	120 feet
		·
Top of lap pipe or reduction in casing:feet. <u>If tel</u>	<u>'escoped or more than one scree</u>	Form: OLWR-SWR 1A (04/08) RECEIVE
		BY: OLW

': "

The sketch below only required for water wells

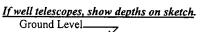

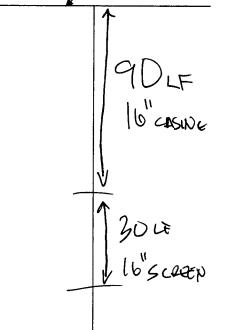

Description of Formations Encountered	From (depth)	To (depth)
TOP 2012	Ground Level	10
CLAY MYCK	10	50
MEDIUM SAND	50	73
FINE 2AND	77	89
COARSE PEGBLES	89	120
BOTOM	120	122
	1	
	~	+
		+
		+
· · · · · · · · · · · · · · · · · · ·		-{
		+
		+
		4
		

Description of formations encountered must be provided for all wells and boreholes, unless specifically exempted by regulations

If more than one screen, show location of each on sketch

Sketch the property layout and include the following: 1) the well location; 2) any permanent structures on the property that may aid in locating the well; 3) any roads, power lines, or other items that may aid in locating the property and the well; 4) a north arrow. SEE MIAP Landowner Name: Form: OLWR-SWR-1A (04/08)

I certify that the well/borehole was drilled, constructed, and completed in accordance with all applicable requirements of the Mississippi Department of Environmental Quality and the Mississippi Department of Health regulations, if applicable, and state laws.

JOHN NEWLOME 0.773 3.14.13

Signature of Licensee ol

Print Name of Responsible Licensee and License No.

Date

, , ,		ELL REPORT	
	County: Washington Provide Part 2		For Office Use Only:
	Permit #: 6W-47029 Mississippi Departme	's Completion Report at of Environmental Quality and Water Resources	Aquifer.
	Driller J. Newcome 0.773 80.	Box 10631 MS 3-783-0631	Well#: N163
)96: 3210 54-6938 (fax)	Elevation:
	This report should be prepared by the purp installer in deta installation of pump.	ail and filed with the Departmen	at within 30 days of the
	Well Owner Information	Wal	Location
	Owner Name: Holly Ridge Planting Co)Longitude: <u>91-04.42</u>
	Mailing Address: 65 Holly Ridge Road	Method of Lat/Long (circle on	
	TI U		-held GPS Survey-grade GPS
	City State Zip Code	IR 14 IR 14 Sec_1	3 TWO LOW Rug 09W
		Distance Direction	Nearest Town
	Telephone No. ()	<u>-5</u> Miles <u>N</u> o	E Challan
	Pump Type		
	Tab Out	Por C	wer Type ncle one
	Air Lift Jet Submersible	Diesel Engine Gasolin	e Engine Natural Gas
	Bucket Piston Turbine	Electric Motor Hand	Tractor PTO
	Centrifugal Rotary Flowing Well	Windmill Other (specify):
	Other (specify):	Horse Power Rating of Motor	
	Date Pump Installed: 3-15-2013	Setting Depth:	feet
	Rated Pump Capacity: 2200 Gallons Per Minute	Number of Stages:	
	Pump Test Data		<u> </u>
	Date Well Tested:	Method of Me	asuring Water Level rcle one
	Static Water Level (A):Foot Below Land Surface	Air Line Electric Mean	suring Line Steel Tape
	Pumping Water Level (B) Fortaclow and Suffrage	Other (specify):	
	Drawdown ((B)-(A)]: <u>Fester</u> Cow and Statione	For Loring well, measured sh	fed
	Test Pumping Rate:Gallons Per Minute	Well yielded	
	Duration of Pump Test (minimum 4 hours):hours		hours of pumping
		3	nows or pumping
	I HEREBY CERTIFY that the above statements are true to the best of	of my knowledge	\wedge
	Hubbard Stephens 741-P Print Name of Pump Installer and License No. (if applicable)	Signature of Pump In	RECEIVED
			MAR 2 5 2013
			BY: Constant

· · · · · ·