

Washington  
 N 1001  
 5-13-80

MISSISSIPPI  
 BOARD OF WATER COMMISSIONERS  
 416 North State Street  
 Jackson, Mississippi 39201

# 3

WATER WELL DRILLERS LOG

Feb. 26 1980 date well completed  
 Ed Larry's Well Drilling firm name  
 Washington county well located

LANDOWNER: Ernest Stone  
 Greenville Miss  
 (mailing address)

description of formations encountered	from	to
clay	0'	20'
fine sand	20'	45'
med sand	45'	58'
coarse sand	58'	90'
un gravel	90'	100'

WELL LOCATION:  
 sec. 32 T 15 N R 8 E  
 S W  
 5 miles north of Glen Allen  
 (distance) (direction) (nearest town)

WELL PURPOSE:  
 (home, irrigation, municipal, industrial)

- WELL COMPLETION DATA:
- (1) diameter (inches) 12"
  - (2) total depth (feet) 100'
  - (3) static water level (feet) 17' below above top of ground.
  - (4) casing steel, 80' (material) (depth)  
 (size) if telescope see back.
  - (5) screen 20' 80' (length) (depth to top)  
 12" steel (size) (material)
  - (6) pump 30 HP 1000 (yield gpm)  
 D (type power)
  - (7) electric log (yes or no)  
 (organization running log)
  - (8) how well bottom plugged steel plate

DRILLERS REMARKS:


DEPT. OF NATURAL RESOURCES  
 BUREAU OF LAND & WATER RESOURCES

MAY 12 1980

RECEIVED

If well telescopes please sketch and show depths.

GROUND LEVEL

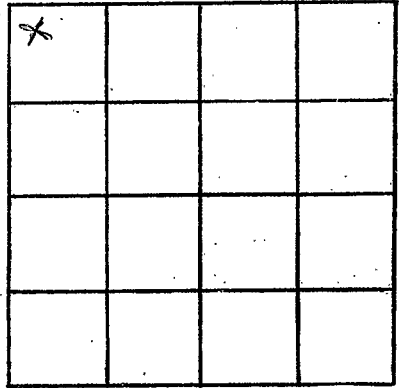

SECTION 32

Please indicate well location X.

ADDITIONAL INFORMATION

If more than one screen,  
show locations of each on sketch.