

Washington
 N 1003
 5-13-80

MISSISSIPPI
 BOARD OF WATER COMMISSIONERS
 416 North State Street
 Jackson, Mississippi 39201
 WATER WELL DRILLERS LOG

2

Feb-22 1980 Larry's Well Lamp Washington
 date well completed firm name county well located

LANDOWNER: Ernest Stone
 Greenville Miss.
 (mailing address)

description of formations encountered	from	to
clay	0'	15'
fine sand	15'	51'
fine to med sand	51'	65'
coarse sand	65'	87'
coarse sand & gravel	87'	120'

WELL LOCATION:
 sec. 32 T-15 N R- E
 S S W
 5 miles north of Greenville
 (distance) (direction) (nearest town)

WELL PURPOSE:
 (home, irrigation, municipal, industrial)

- WELL COMPLETION DATA:
- (1) diameter (inches) 12"
 - (2) total depth (feet) 120'
 - (3) static water level (feet) 15' below top of ground.
 - (4) casing steel 80' (material) (depth)
 12" (size) If telescope see back.
 - (5) screen 40 80' (length) (depth to top)
 12" steel (size) (material)
 - (6) pump 100 1000 (HP) (yield gpm)
 D (type power)
 - (7) electric log (yes or no)
 (organization running log)
 - (8) how well bottom plugged steel plate

DRILLERS REMARKS:


DEPT. OF NATURAL RESOURCES
 BUREAU OF LAND & WATER RESOURCES

MAY 12 1980

RECEIVED

If well telescopes please sketch and show depths.

GROUND LEVEL

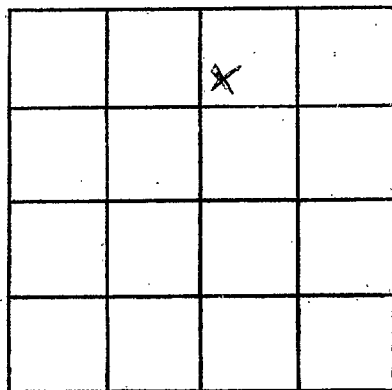

SECTION 32

Please indicate well location X.

ADDITIONAL INFORMATION

If more than one screen,
show locations of each on sketch.