

MISSISSIPPI DEPARTMENT OF NATURAL RESOURCES
Bureau of Land and Water Resources
 Southport Mall
 P.O. Box 10631
 Jackson, Mississippi 39209
WATER WELL DRILLERS LOG

Washington
N 100A

8-3- 1983 Bustane Gas Co. Greenwood Washington
 date well completed firm name county well located

LANDOWNER:	description of formations encountered	from	to
<u>Gibb Steel</u>			
<u>Longwood Farms</u>	<u>Small</u>	<u>50</u>	<u>70</u>
<u>Hollandsville, MS</u> (mailing address)	<u>Sand & gravel</u>	<u>70</u>	<u>113</u>

WELL LOCATION:
 sec. 17 T. 15 N. R. 2 E.
1.5 miles E. of Longwood
 (distance) (direction) (nearest town)

WELL PURPOSE: Irrigation
 (home, irrigation, municipal, industrial)

- WELL COMPLETION DATA:**
- diameter (inches) 16"
 - total depth (feet) 113
 - static water level (feet) 18 below top of ground.
 - casing Steel, 73'
 (material) (depth)
16" if telescope see back.
 (size)
 - screen 40 73
 (length) (depth to top)
16 Steel
 (size) (material)
 - pump _____
 (HP) (yield gpm)
Diesel
 (type power)
 - electric log No
 (yes or no)
No
 (organization running log)

(8) how well bottom plugged Steel plate

DRILLERS REMARKS:
Carlos James


DEPT. OF NATURAL RESOURCES
 BUREAU OF LAND & WATER RESOURCES

AUG 12 1983

RECEIVED

If well telescopes please sketch and show depths.

GROUND LEVEL

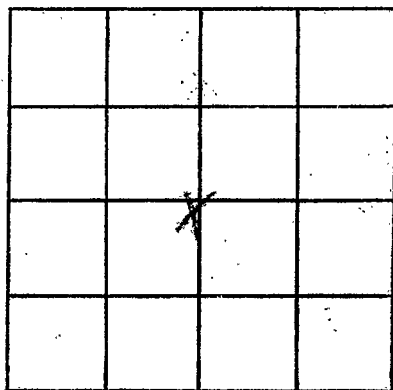

SECTION 17

Please indicate well location X.

ADDITIONAL INFORMATION

If more than one screen, show locations of each on sketch.