

WASHINGTON
 N 2000
 6-8-76

MISSISSIPPI
 BOARD OF WATER COMMISSIONERS
 416 North State Street
 151 Jackson, Mississippi 39201

WATER WELL DRILLERS LOG

June 8 1976 Bailey Drilling Co Washington
 Date well completed firm name county well located

LANDOWNER: Leo Williams

Hollandale, Miss.

(mailing address)

WELL LOCATION:

sec. 14 T 15 N R. 8 E
7 miles W of Hollandale
 (distance) (direction) (nearest town)

WELL PURPOSE: farm
 (home, irrigation, municipal, industrial)

WELL COMPLETION DATA:


- (1) diameter (inches) 4X3X2 1/2
- (2) total depth (feet) 724
- (3) static water level (feet) 29 below above top of ground.
- (4) casing Steel, 694,
 (material) (depth)
4X3X2 If telescope see back.
 (size)
- (5) screen 30', 694
 (length) (depth to top)
2 1/2", Stainless Steel
 (size) (material)
- (6) pump 3 50
 (HP) (yield gpm)
Electric
 (type power)
- (7) electric log no
 (yes or no)

(organization running log)

(8) how well bottom plugged Back
pressure valve


DRILLERS REMARKS:

description of formations encountered	from to	
Play	0	40
Sand	40	70
Gravel	70	90
Mud	90	116
Rock	116	116 1/2
Sand-mud	116 1/2	200
Mud	200	320
Sand	320	360
Mud	360	364
Sand	364	430
Mud	430	540
Sand-mud	540	580
Sand-Coal	580	600
Sand	600	724

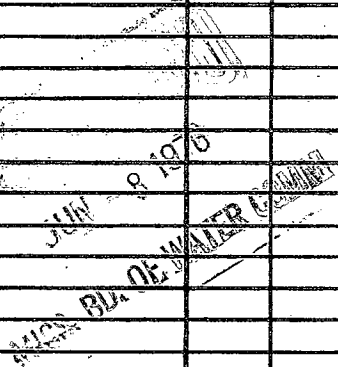

If well telescopes please sketch and show depths.

GROUND LEVEL

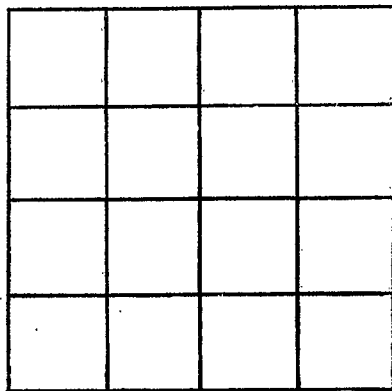

SECTION _____

Please indicate well location X.

ADDITIONAL INFORMATION

If more than one screen, show locations of each on sketch.