

WASHINGTON
 N 2500
 12/16/77

MISSISSIPPI
 BOARD OF WATER COMMISSIONERS
 416 North State Street
 Jackson, Mississippi 39201

WATER WELL DRILLERS LOG

12 / 16 1977 Schultz Drilling Co. Washington
 date well completed firm name county well located

LANDOWNER: C. G. Steele
 Longwood
 Hollandale MS
 (mailing address)

WELL LOCATION:
 sec 11 T 15 N R 8 E
 S W
 8 miles W of Hollandale
 (distance) (direction) (nearest town)

WELL PURPOSE:
 (home, irrigation, municipal, industrial)

- WELL COMPLETION DATA:
- (1) diameter (inches) 4 X 2
 - (2) total depth (feet) 1075
 - (3) static water level (feet) 26 below top of ground.
 - (4) casing Steel 1050 (material) (depth)
 - (5) screen 25 (length) (depth to top) Steel
 - (6) pump 1 1/2 (HP) 20 (yield gpm) stainless steel
 - (7) electric log no (yes or no)
 - (8) how well bottom plugged b/wash

description of formations encountered	depth	
	from	to
Clay	0	20
SAND	28	105
SANDY shale	105	173
ROCK	173	176
sandy shale	176	240
SAND	246	400
shale	400	500
clay	500	540
sandy shale	540	727
silty sand	727	767
clay	767	847
sand	847	884
ROCK	884	885
clay	885	960
ROCK	960	960
clay	960	1008
SAND	1008	1075


RECEIVED
 ALL
 JAN 26 1978

DRILLERS REMARKS:

MISS. BD. OF WATER COMM

If well telescopes please sketch and show depths.

GROUND LEVEL

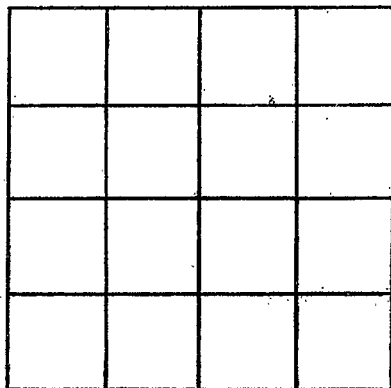

SECTION _____

Please indicate well location X.

ADDITIONAL INFORMATION

If more than one screen, show locations of each on sketch.