

WASHINGTON
 N 2004
 02-27-79

MISSISSIPPI
 BOARD OF WATER COMMISSIONERS
 416 North State Street
 Jackson, Mississippi 39201
 WATER WELL DRILLERS LOG

February 27, 1979
 date well completed

Bruce Berryman-
 firm name
 Greenwood, MS

WASHINGTON
 county well located

LANDOWNER: Mr. Ernest Stone
 Description of formations encountered

P.O. Box 5404
 Greenville, Ms. 38701
 (mailing address)

	from	to
Clay	0	10
Sand	10	80
Sand & Gravel	80	100
Shale	100	120
Shale & Str. sand	120	220
Sand	220	300
Sand & Str. Shale	300	360
Shale	360	420
Sand & Str. shale	420	500
Sand	500	540
Shale	540	560
Sand	560	580
Shale	580	600
Sand	600	620
Shale	620	740
Fine sand	740	760
Shale	760	780
Sand	780	850
Clay	850	860

WELL LOCATION:
 sec. 32 T 15 N R 8 W
5 miles (distance) N (direction) of GLENN ALLEN (nearest town)

WELL PURPOSE: Home
 (home, irrigation, municipal, industrial)

WELL COMPLETION DATA:

(1) diameter (inches) 4" x 2"

(2) total depth (feet) 840 ft.

(3) static water level (feet) 21' below top of ground. 4" blk. - 126'

(4) casing 2" galv. (material) - 693' (depth)

 If telescope see back.
 (size)

(5) screen 20' (length) , 820' (depth to top)

2" (size) , Stainless steel (material)

(6) pump 1 h.p. (HP) , 19 (yield gpm)

Electric (type power)

(7) electric log No (yes or no)

 (organization running log)

(8) how well bottom plugged B.P.V.

DRILLERS REMARKS:


Miss. Board of Water Comm.

MAY - 8 1979

RECEIVED

If well telescopes please sketch and show depths.

GROUND LEVEL

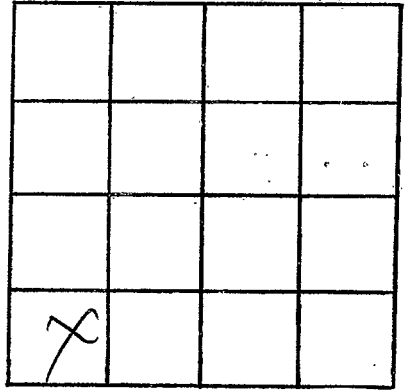

SECTION 32

Please indicate well location X.

ADDITIONAL INFORMATION

If more than one screen,
show locations of each on sketch.