

Washington
 N 2005
 5-13-80

MISSISSIPPI
 BOARD OF WATER COMMISSIONERS
 416 North State Street
 Jackson, Mississippi 39201

WATER WELL DRILLERS LOG

Jan. 29 1980 Bruce Berryman - WASHINGTON
 date well completed firm name county well located
 Greenwood.

LANDOWNER: Mr. Marion Stev Stevens. Box 116 Glenn Allen, MS 38746 (mailing address)	description of formations encountered	from	to
	Clay	0	20
	Sand	20	80
	Sand & Gravel	80	160
	Clay	160	180
	Sand	180	360
	Sandy clay	360	420
	Sand	420	440
	Sandy shale	440	540
	Sand & Str. shale	540	660
	Sand	660	680
	Shale	680	740
	Sand	740	870

WELL LOCATION:
 sec. 30 T 15 N R E
 S S W
 S miles N of GLENN ALLEN
 (distance) (direction) (nearest town)

WELL PURPOSE: Home
 (home, irrigation, municipal, industrial)

WELL COMPLETION DATA:

- (1) diameter (inches) 4" x 2"
- (2) total depth (feet) 840 feet.
- (3) static water level (feet) 18 below top of ground.
- (4) casing 2" galv. - 126' (material) (depth) 694'
- (size) if telescope see back.
- (5) screen 20' (length) 820' (depth to top)
 .010, Stainless steel (size) (material)
- (6) pump 1 1/2 (HP) 30 (yield gpm)
 Electric (type power)
- (7) electric log No (yes or no)
 (organization running log)
- (8) how well bottom plugged B.P.V.

DEPT. OF NATURAL RESOURCES
 BUREAU OF LAND & WATER RESOURCES


MAY 12 1980

RECEIVED

DRILLERS REMARKS:

If well telescopes please sketch and show depths.

GROUND LEVEL

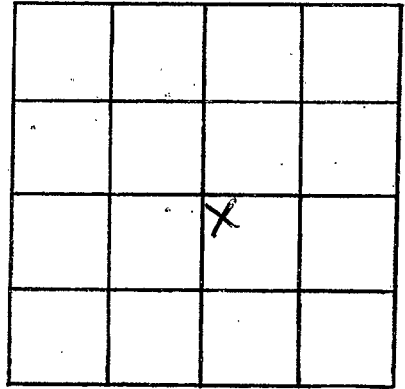

SECTION 32

Please indicate well location X.

ADDITIONAL INFORMATION

If more than one screen,
show locations of each on sketch.