

MISSISSIPPI DEPARTMENT OF NATURAL RESOURCES

Bureau of Land and Water Resources

Southport Mall

P.O. Box 10631

Jackson, Mississippi 39209

WATER WELL DRILLERS LOG

WASHINGTON
 N 2000

Nov 08

1985

Larry's well & pump

firm name

Washington

county well located

LANDOWNER: Wayne Davis

description of formations encountered

from

to

Avon, Ms.

(mailing address)

SAND

580

760

WELL LOCATION:

sec. 15 T. 15 N. S.

R. 8 E. W.

10 miles West of Hollandale
 (distance) (direction) (nearest town)

WELL PURPOSE:

(home) irrigation, municipal, industrial

WELL COMPLETION DATA:

- (1) diameter (inches) 4" x 2"
- (2) total depth (feet) 700
- (3) static water level (feet) 20' below top of ground.

(4) casing PVC, 720
 (material) (depth)

4x2 if telescope see back.
 (size)

(5) screen 40, 720 + 760
 (length) (depth to top)

2" PVC
 (size) (material)

(6) pump 1, 70
 (HP) (yield gpm)

Elec.
 (type power)

(7) electric log No.
 (yes or no)

(organization running log)

(8) how well bottom plugged sand

RECEIVED

MAY 11 1987

Department of Natural Resources
 Bureau of Land & Water Resources

DRILLERS REMARKS:


If well telescopes please sketch and show depths.

GROUND LEVEL

140' 4" PVC

58' 2" PVC

40' 2" PVC
Screen

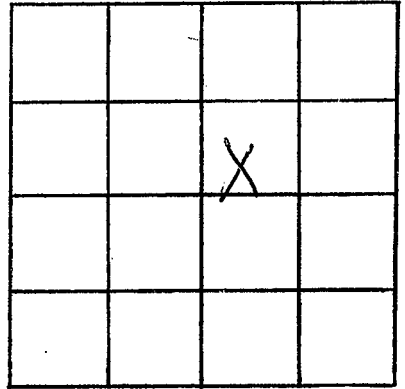

SECTION 15

Please indicate well location X.

ADDITIONAL INFORMATION

If more than one screen,
show locations of each on sketch.