

MISSISSIPPI DEPARTMENT OF NATURAL RESOURCES

Bureau of Land and Water Resources

Southport Mall

P.O. Box 10631

Jackson, Mississippi 39209

WATER WELL DRILLERS LOG

CODED

WASHINGTON
 CL-22329
 7-20-82

?belong in
 grid

7/20 19 82 LAYNE-CENTRAL CO. WASHINGTON
 date well completed firm name county well located

LANDOWNER:	description of formations encountered	from	to
Opossum Ridge Farm			
Hollandale, MS 38748	fine sand	14	22
(mailing address)	med.coarse sand	22	32
WELL LOCATION:	coarse sand	32	52
sec. 12 T 15 N R 8 W	coarse sand	52	62
1/2 miles W of Hollandale	coarse sand	62	72
(distance) (direction) (nearest town)	coarse sand & pea grav.	72	82
WELL PURPOSE: irrigation	c.sand & gravel	82	92
(home, irrigation, municipal, industrial)	gravel	92	112
WELL COMPLETION DATA:	c.sand & gravel	112	117
(1) diameter (inches) 32"	clay	117	118

CODED

- (1) diameter (inches) 32"
- (2) total depth (feet) 117'
- (3) static water level (feet) 22' below top of ground.
- (4) casing steel 67' (material), (depth) 16" (size) if telescope see back.
- (5) screen 50' (length), 67' (depth to top) 16" (size), st. steel (material)
- (6) pump 40 (HP), 2000 (yield gpm) gear drive (type power)
- (7) electric log no (yes or no)
- (organization running log)
- (8) how well bottom plugged plate

DEPT. OF NATURAL RESOURCES
 BUREAU OF LAND & WATER RESOURCES


SEP - 8 1982

RECEIVED

DRILLERS REMARKS:

If well telescopes please sketch and show depths.

GROUND LEVEL

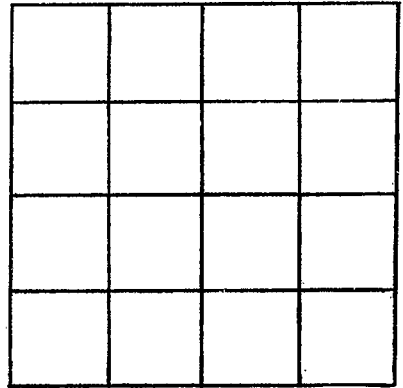

SECTION _____

Please indicate well location X.

ADDITIONAL INFORMATION

If more than one screen,
show locations of each on sketch.