

WATER WELL DRILLERS LOG

Date: FEB 18, 1965, Driller: DELTA DRILLING Co. County WASHINGTON
 (Name)

(1) Owner of Land: FRED BELL
 (Name)
PERCY, MISS. (HOLLAND AVE)
 (Address)

(2) Location: SW 1/4, NE 1/4, Sec. 27 T15R21W
 _____ miles _____ of _____
 (distance) (direction) (Nearest Town)

(3) Topography: _____
 (Hilly) (Flat) (Level)

(4) Purpose of Well: DOMESTIC
 (Domestic Irrigation
 Municipal, Industrial, Other)

Information upon completion of well:

(1) Diameter 3 inches.

(2) Total Depth 1633 feet.

(3) Water Level WELL FLOWS feet below top of ground. 985 ± 2"

(4) Cased to 1595, Size 651'-3"

(5) Screen: Size 2", Length 20'


(6) Were any formations sealed against pollution?
 _____ yes, _____ no.

If YES depth of formation _____

Why _____

Drillers Remarks: WELL FLOWS 60 gpm.
18'-2" BLANK PIPE ON
BOTTOM OF WELL

Description & Color of Materials Sand, Clay, Red Clay, Shell, etc.	Thick- ness Feet	Depth Feet
SAND	87	87
GRAVEL	41	128
SAND w/6" ROCK	93	221
SHALE w/4" "	65	286
GUMBO	81	367
SHALE	32	399
GUMBO	24	423
SAND	32	455
SHALE	26	481
SAND w/6" ROCK	70	551
SHALE	34	585
GUMBO	26	611
SHALE	18	629
GUMBO	48	677
SHALE	35	712
SAND	26	738
SHALE	79	817
SAND	60	877
GUMBO w/6" ROCK	90	967
SHALE	70	1037
GUMBO	15	1052
SHALE	45	1097
GUMBO w/ROCKS	69	1166
SHALE	40	1206
GUMBO	165	1371
SHALE w/ROCK	44	1415
GUMBO	70	1485
SHALE	40	1525
GUMBO	33	1558
SAND	79	1637
SHALE	73	1690
SAND	37	1727
SHALE	6	1733

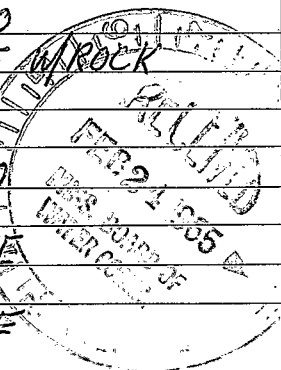

Miss Geo. Searcy E-109 5-1200'

(Use Back Side)

