

Φ20

7-30-65

WATER WELL DRILLERS LOG

**CODED**

Date: 7/30, 1965, Driller: Bailey Drilling Co. County: Washington  
(Name)

(1) Owner of Land: E J Yarnier  
(Name)  
Perey  
(Address)

(2) Location: NE 1/4, NW 1/4, Sec 36 T15R7,  
at Perey  
miles (distance) of (direction) (Nearest Town)

(3) Topography: flat  
(Hilly) (Flat) (Level)

(4) Purpose of Well: Domestic  
(Domestic Irrigation  
Municipal, Industrial, Other)

Description & Color of Materials Sand, Clay, Red Clay, Shell, etc.	Thick- ness Feet	Depth Feet
Clay		30
Sand		80
Gravel		140
Mud		260
Sand		290
Mud		610
Rock		611
Mud		620
Sand		690
Rock		691
Sand		742

Information upon completion of well:

(1) Diameter 4x3x2 1/2 inches.

(2) Total Depth 742 feet.

(3) Water Level 19 feet below top of ground.

(4) Cased to all way Size 4x3x2 1/2

(5) Screen: Size 2 1/2, Length 30 ft.


(6) Were any formations sealed against pollution?  
 yes,  no.

**CODED**

If YES depth of formation \_\_\_\_\_

Why \_\_\_\_\_

Drillers Remarks: \_\_\_\_\_

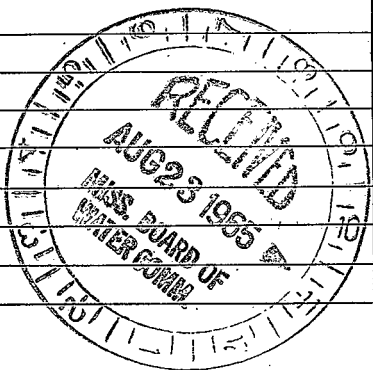

(Use Back Side)

Well No.

100