

Washington
 #21
 11-66

MISSISSIPPI BOARD OF WATER COMMISSIONERS

WATER WELL DRILLERS LOG

Date: 11/5, 1966, Driller: Bailey Drilling Co County: Washington
 (Name)

(1) Owner of Land:	Description & Color of Materials Sand, Clay, Red Clay, Shell, etc.	Thick- ness Feet	Depth Feet
<u>Leo F. Williams</u> (Name)			
<u>R 1, Hollandale, Miss.</u> (Address)	<u>Clay</u>	<u>20</u>	<u>20</u>
	<u>Sand</u>	<u>62</u>	<u>82</u>
(2) Location: <u>NE 1/4 of SW 1/4, Sec. 7 T15 N R 7 W</u>	<u>Gravel</u>	<u>30</u>	<u>112</u>
<u>8</u> miles <u>West</u> of <u>Hollandale</u> (distance) (direction) (Nearest Town)	<u>Mud</u>	<u>63</u>	<u>175</u>
(3) Topography: <u>Flat</u> (Hilly) (Flat) (Level)	<u>Sand</u>	<u>80</u>	<u>255</u>
(4) Purpose of Well: <u>Domestic</u> (Domestic Irrigation Municipal, Industrial, Other)	<u>Mud</u>	<u>50</u>	<u>305</u>
	<u>Rocks</u>	<u>3</u>	<u>308</u>
	<u>Mud</u>	<u>72</u>	<u>380</u>
	<u>Sand</u>	<u>116</u>	<u>496</u>

Information upon completion of well:


- (1) Diameter 4 x 3 inches.
- (2) Total Depth 996 feet.
- (3) Water Level 22 feet below top of ground.
- (4) Cased to all way size 4 x 3.
- (5) Screen: Size 3", Length 30'.
- (6) Were any formations sealed against pollution?

yes, no.

If YES depth of formation _____

Why _____

Drillers Remarks: _____

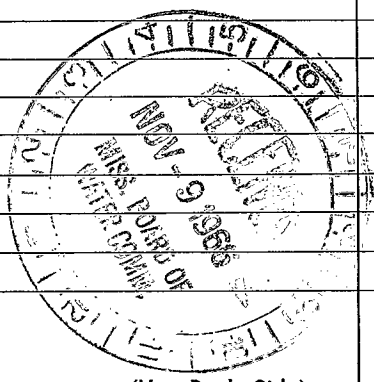

(Use Back Side)

Well No.

