

WASHINGTON

Ø 28

2-28-69

MISSISSIPPI  
BOARD OF WATER COMMISSIONERS  
416 North State Street  
Jackson, Mississippi 39201

WATER WELL DRILLERS LOG

2-28

1969 DYER WELL FIRE SQ WASH.

date well completed

firm name

county well located

LANDOWNER:

ALBERT PREDOT

HOLLANDAWE MISSISSIPPI  
(mailing address)

WELL LOCATION:

sec. 18 T. 15 N. R. 7 W  
6 miles W of HOLLANDAWE  
(distance) (direction) (nearest town)

WELL PURPOSE: FISH  
(home, irrigation, municipal, industrial)

WELL COMPLETION DATA:

- (1) diameter (inches) 16"
- (2) total depth (feet) 130'
- (3) static water level (feet) 12' below above top of ground.
- (4) casing BLK IR., 90'  
(material) (depth)  
16" If telescope see back.  
(size)
- (5) screen 40', 90'  
(length) (depth to top)  
16", BLK IR.  
(size) (material)
- (6) pump 50 2500  
(HP) (yield gpm)  
DIESEL  
(type power)
- (7) electric log No  
(yes or no)

(organization running log)

(8) how well bottom plugged PLATE

DRILLERS REMARKS:

description of formations encountered

from to

CLAY	10	13
CLAY & FINE SAND	13	23
Coarse Brown Sand	23	33
" " "	33	43
Med. Sand	43	53
Coarse Sand 5' Med.	53	63
Fine Sand 5' Med.	63	73
Fine Sand	73	83
Coarse Sand & Grubs	83	93
Fine Sand	93	103
Fine Sand 5' Headed L.	103	113
Clear Gravel	113	133
Clear Gravel	133	133


COPYED

MAR 13 1969

MISS. BD. OF  
WATER COMMISSIONERS

If well telescopes please sketch and show depths.

GROUND LEVEL

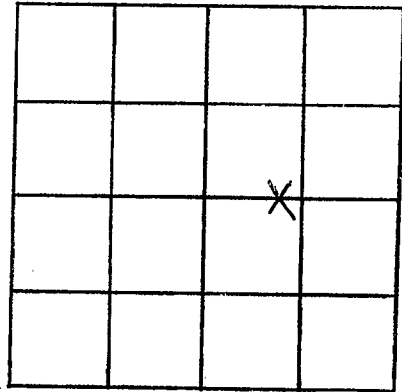

SECTION 6

Please indicate well location X.

ADDITIONAL INFORMATION

If more than one screen, show locations of each on sketch.