

WASH.
 35
 1-31-75
 E log 88

MISSISSIPPI
 BOARD OF WATER COMMISSIONERS
 416 North State Street
 Jackson, Mississippi 39201

CODED

WATER WELL DRILLERS LOG

January 31, 1975 Singer-Layne Central Div. Washington
 date well completed firm name county well located

LANDOWNER:	description of formations encountered	from	to
Miss. State Park Commission			
Jackson, Mississippi	Clay	0	14
(mailing address)	Sand	14	83
WELL LOCATION:	Coarse Sand & Pea Gravel	83	127
sec. 16 T 15 N R 7 W	Sand & Cemented Gravel	127	131
3 miles west of Hollandale	Clay	131	212
(distance) (direction) (nearest town)	Soft Rock	212	214
WELL PURPOSE: municipal	Clay	214	280
(home, irrigation, municipal, industrial)	Fine Sand & Clay streaks	280	321
WELL COMPLETION DATA:	Clay	321	375
(1) diameter (inches) 8" x 6"	Sand	375	389
(2) total depth (feet) 473	Shale	389	401
(3) static water level (feet) 11' 7" below top of ground.	Sandy shale with Sand Str	401	432
(4) casing steel, 431' (material) (depth)	Sand	432	468
8" If telescope see back. (size)	Clay	468	530
(5) screen 35' (length), 432' (depth to top)			
6" stainless steel (size) (material)			
(6) pump 7.5 (HP), 100 (yield gpm)			
electric (type power)			
(7) electric log yes (yes or no)			
U.S.G.S. (organization running log)			
(8) how well bottom plugged lead shot			
DRILLERS REMARKS:			

432
33
17


CODE

CODED

FEB 28 1975
 MISS. BD. OF WATER COMMISSIONERS

If well telescopes please sketch and show depths.

GROUND LEVEL

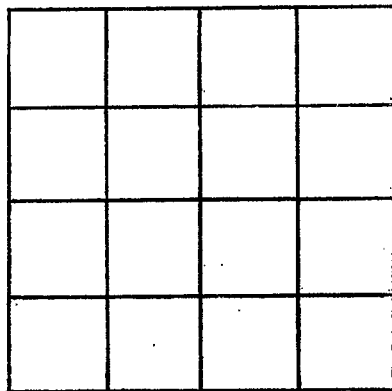

SECTION _____

Please indicate well location X.

ADDITIONAL INFORMATION

If more than one screen, show locations of each on sketch.