

WASH.
 Ø 36
 3-5-75

MISSISSIPPI
 BOARD OF WATER COMMISSIONERS
 416 North State Street
 Jackson, Mississippi 39201

CODED

WATER WELL DRILLERS LOG

3/5 1975 Bailey Drilling Co. Washington
 date well completed firm name county well located

LANDOWNER: Washington County
Greenville
Miss.
 (mailing address)

description of formations encountered	from	to
Clay	0	20
Sand	20	60
Gravel	60	100

WELL LOCATION:
 sec. 16 T 15 N R X E
5 miles SE of Holland
 (distance) (direction) (nearest town)


WELL PURPOSE: Wash. tractor
 (home, irrigation, municipal, industrial)

- WELL COMPLETION DATA:
- (1) diameter (inches) 4"
 - (2) total depth (feet) 100.29
 - (3) static water level (feet) 19 below top of ground.
 - (4) casing steel, 90'
 (material) (depth)
4" if telescope see back.
 (size)
 - (5) screen 10', 90'
 (length) (depth to top)
4", stainless steel
 (size) (material)
 - (6) pump 2, 30
 (HP) (yield gpm)
Electric
 (type power)
 - (7) electric log No
 (yes or no)
- (organization running log)

CODED

(8) how well bottom plugged back pressure valve

DRILLERS REMARKS:

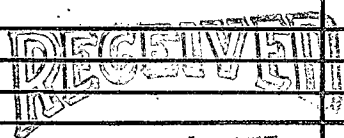


MAY 6 1975

MISS. BO. OF WATER COMM.

If well telescopes please sketch and show depths.

GROUND LEVEL

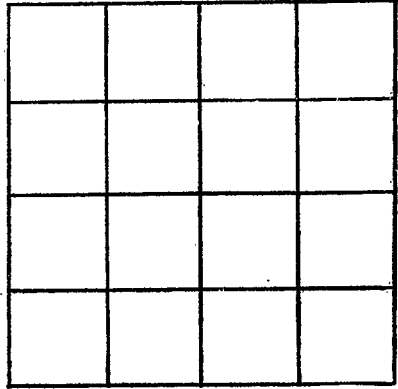

SECTION _____

Please indicate well location X.

ADDITIONAL INFORMATION

If more than one screen, show locations of each on sketch.