

WASHINGTON
Φ 38
6-18-76

BOARD OF WATER COMMISSIONERS
416 North State Street
Jackson, Mississippi 39201

WATER WELL DRILLERS LOG

CODED

6-18
date well completed

1976 DYER-SULLIVAN, INC.
firm name

WASHINGTON
county well located

LANDOWNER: Hill Bros.
Hollandale, Miss.
(mailing address)

description of formations encountered	from	to
	Clay	0
Fine sand	19	28
med sand	28	41
Coarse sand & gravel	41	113

WELL LOCATION:
sec. 26 T-15 N R-7 W
4 miles SE of Hollandale
(distance) (direction) (nearest town)

WELL PURPOSE: Irrigation
(home, irrigation, municipal, industrial)

- WELL COMPLETION DATA:
- (1) diameter (inches) 16"
 - (2) total depth (feet) 113'
 - (3) static water level (feet) 17' below top of ground.
 - (4) casing Steel, 73' (material) (depth)
16" (size) if telescope see back.
 - (5) screen 40' (length), 73' (depth to top)
16" (size), Steel (material)
 - (6) pump 60 (HP), 2400 (yield gpm)
Diesel (type power)
 - (7) electric log NO (yes or no)
 - (8) how well bottom plugged plate

RECEIVED


AUG 28 1976

DRILLERS REMARKS:

MISS. BD. OF WATER COMM

If well telescopes please sketch and show depths.

GROUND LEVEL

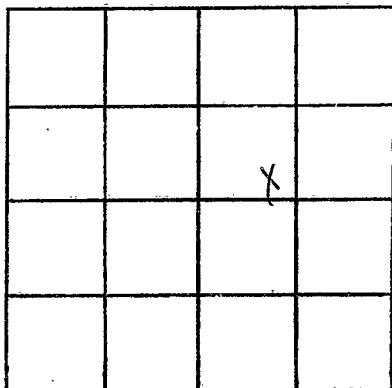

SECTION _____

Please indicate well location X.

ADDITIONAL INFORMATION

If more than one screen,
show locations of each on sketch.