

Washington
 41
 10-19-79

MISSISSIPPI
 BOARD OF WATER COMMISSIONERS
 416 North State Street
 Jackson, Mississippi 39201

CODED

WATER WELL DRILLERS LOG

10-19 19 79 Laney's Well & Pump Washington
 date well completed firm name county well located

LANDOWNER: Hariston
Percy Miss.
 (mailing address)

WELL LOCATION:
 sec. 36 T. 15 (N) R. 7 (E)
4 miles S of Hollandale
 (distance) (direction) (nearest town)

WELL PURPOSE:
 (home, irrigation, municipal, industrial)

- WELL COMPLETION DATA:
- (1) diameter (inches) 4 1/2
 - (2) total depth (feet) 738'
 - (3) static water level (feet) 31 ^{below} _{above} top of ground.
 - (4) casing steel 718'
 (material) (depth)
 (size) if telescope see back.
 - (5) screen 20 718'
 (length) (depth to top)
2" stainless steel
 (size) (material)
 - (6) pump 2 40
 (HP) (yield gpm)
Electric
 (type power)
 - (7) electric log _____
 (yes or no)
 (organization running log)
 - (8) how well bottom plugged wash valve

description of formations encountered	from	to
clay	0'	17'
fine sand	17'	30'
med sand	30'	38'
coarse sand	38'	75'
coarse sand + siltstone	75'	125'
clay	125'	180'
sand	180'	235'
clay	235'	285'
clay & sand	285'	493'
sand + clay	493'	685'
fine sand	687'	697'
med. sand	697'	727'
coarse sand	727'	738'


DEPT. OF NATURAL RESOURCES
 BUREAU OF LAND & WATER RESOURCES

NOV 15 1979

RECEIVED

DRILLERS REMARKS:

If well telescopes please sketch and show depths.

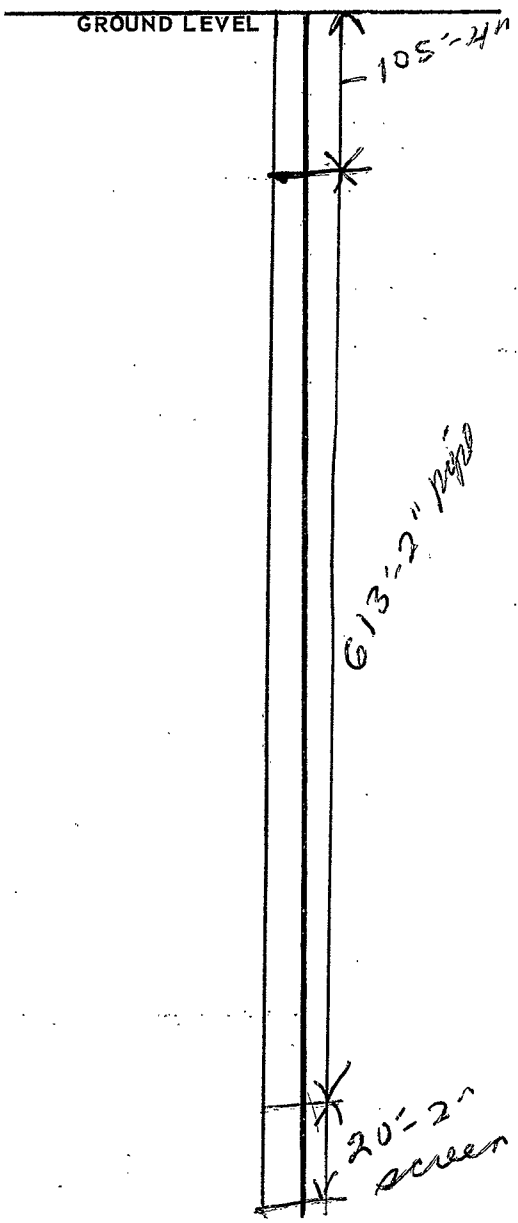

*			

SECTION 36

Please indicate well location X.

ADDITIONAL INFORMATION

If more than one screen, show locations of each on sketch.