

Washington
 10-16-79

MISSISSIPPI
 BOARD OF WATER COMMISSIONERS
 416 North State Street
 Jackson, Mississippi 39201

CODED

WATER WELL DRILLERS LOG

10-16 date well completed 1979 Larry's Well Pumping firm name Washington county well located

LANDOWNER: Gene Jones
 Percy Miss.
 (mailing address)

WELL LOCATION:
 sec. 36 T. 15 N. R. 7 E. S. 7 W.
 1/4 miles S of Hollandal
 (distance) (direction) (nearest town)

WELL PURPOSE:
 (home, irrigation, municipal, industrial)

WELL COMPLETION DATA: 110" - 21"

- (1) diameter (inches) 4 1/2"
- (2) total depth (feet) 738'
- (3) static water level (feet) 31' below top of ground.
- (4) casing plastic, 718' (material) (depth)
 (size) If telescope see back.
- (5) screen 20' 718' (length) (depth to top)
 2" plastic (size) (material)
- (6) pump 1 20 (HP) (yield gpm)
 Electric (type power)
- (7) electric log (yes or no)
 (organization running log)
- (8) how well bottom plugged Work valve

description of formations encountered	from	to
Clay	0'	18'
med sand	18'	27'
Coarse sand	27'	60'
Coarse sand + sandstone	60'	85'
Coarse sand	85'	127'
clay	127'	170'
sand	170'	235'
clay	235'	283'
clay + sand	283'	490'
sand	490'	518'
clay	518'	523'
sand	523'	582'
clay + sand	582'	685'
fine sand	685'	700'
med sand	700'	728'
coarse sand	728'	738'


DEPT. OF NATURAL RESOURCES
 BUREAU OF LAND & WATER RESOURCES

NOV 15 1979

RECEIVED

DRILLERS REMARKS:

If well telescopes please sketch and show depths.

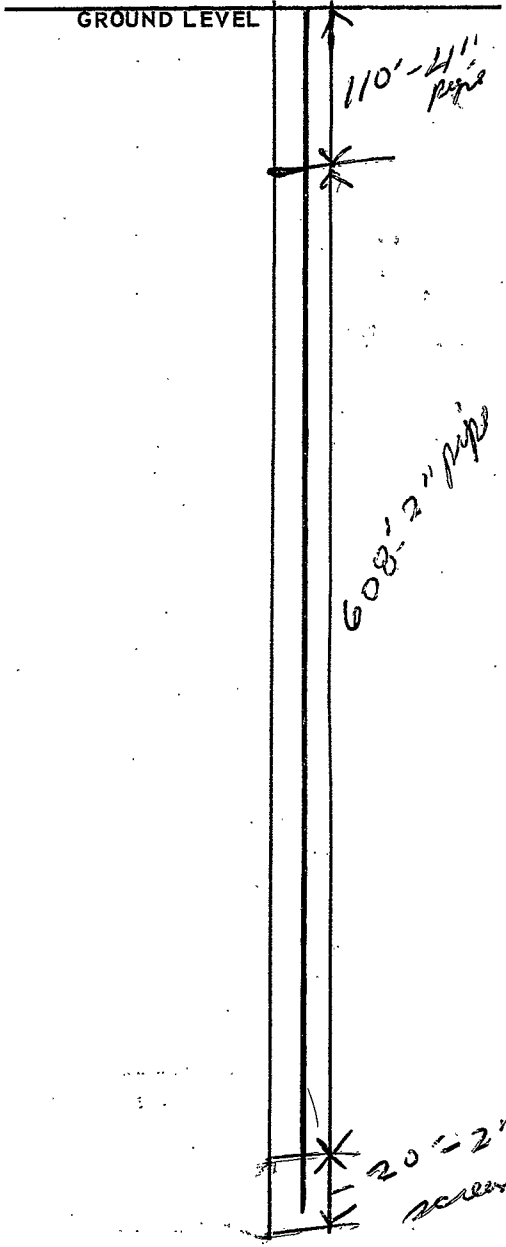

X			

SECTION 36

Please indicate well location X.

ADDITIONAL INFORMATION

If more than one screen, show locations of each on sketch.