


Washington  
 CL-1461  
 0 44  
 6-6-80  
 6/6/

MISSISSIPPI  
 BOARD OF WATER COMMISSIONERS  
 416 North State Street  
 Jackson, Mississippi 39201

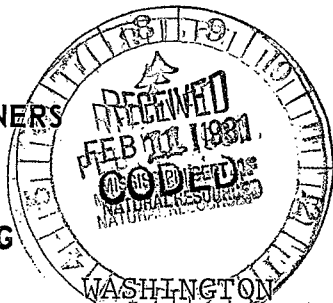


WATER WELL DRILLERS LOG

19 80 LAYNE-CENTRAL CO. date well completed firm name county well located

LANDOWNER:	description of fomations encountered	from	to
FONTENOT & FONTENOT	clay	0	14
RICE FARMS	"	14	22
HOLLANDALE, MS	fine sand	22	32
(mailing address)	"	32	42
WELL LOCATION:	med. sand	42	52
sec. 1 T 15 N R 7 E	coarse sand & pea. gr	52	62
3 miles NW of Holland	"	62	72
(distance) (direction) (nearest town)	"	72	82
WELL PURPOSE: irrigation	" & gravel	82	92
(home, irrigation, municipal, industrial)	"	92	102
WELL COMPLETION DATA:	"	102	112
(1) diameter (inches) 32"	"	112	122
(2) total depth (feet) 122'			
(3) static water level (feet) 21' below top of ground.			
(4) casing steel 72' (material) (depth)			
16" (size) If telescope see back.			
(5) screen 50' 72' (length) (depth to top)			
16" st. steel (size) (material)			
(6) pump 50 2400 (HP) (yield gpm)			
electric (type power)			
(7) electric log no (yes or no)			
(organization running log)			
(8) how well bottom plugged st. plate			
DRILLERS REMARKS:			

If well telescopes please sketch and show depths.

GROUND LEVEL

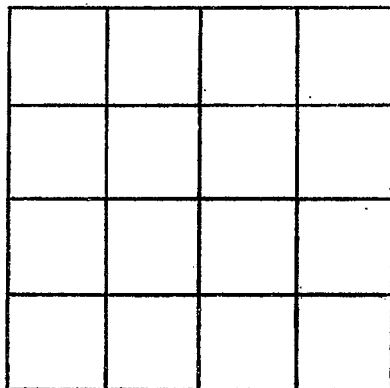

SECTION \_\_\_\_\_

Please indicate well location X.

ADDITIONAL INFORMATION

If more than one screen, show locations of each on sketch.