

MISSISSIPPI DEPARTMENT OF NATURAL RESOURCES

Bureau of Land and Water Resources

Southport Mall

P.O. Box 10631

Jackson, Mississippi 39209

WATER WELL DRILLERS LOG

CODED

WASHINGTON  
 # 45  
 7-10-80

7/10/80 19 Larry's Well & Pump Washington  
 date well completed firm name county well located


LANDOWNER: Huber Farm Ser.	description of formations encountered	from	to
Greenville, ms. (mailing address)	clay	0	20
	fractured	20	30
	med sand	50	75
	coarse sand gravel	75	120
WELL LOCATION: sec. 15 T. 15 N. R. 7 E. S. 1 W. SW miles 15 of Hollandale (distance) (direction) (nearest town)			
WELL PURPOSE: (home, irrigation, municipal, industrial)			
WELL COMPLETION DATA:			
(1) diameter (inches) 16"			
(2) total depth (feet) 120'			
(3) static water level (feet) 17' below top of ground.			
(4) casing Steel, 80' (material) (depth)			
(size) If telescope see back.			
(5) screen 40', 80' (length) (depth to top)			
16", Steel (size) (material)			
(6) pump 1/2 HP, 2000 (HP) (yield gpm)			
Electrical (type power)			
(7) electric log No (yes or no)			
(organization running log)			
(8) how well bottom plugged Steel plate.			
DRILLERS REMARKS:			

CODED

DEPT. OF NATURAL RESOURCES  
 BUREAU OF LAND & WATER RESOURCES  
 RECEIVED  
 APR 28 1981

If well telescopes please sketch and show depths.

GROUND LEVEL

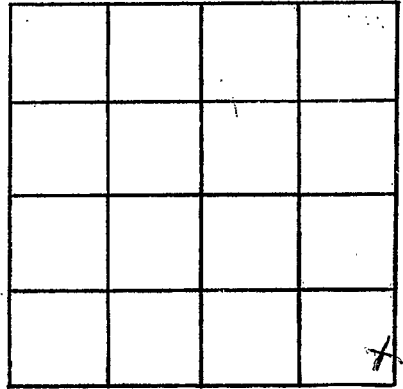

SECTION 15

Please indicate well location X.

ADDITIONAL INFORMATION

If more than one screen,  
show locations of each on sketch.