

Washington

Q 46

2-11-80

MISSISSIPPI BOARD OF WATER COMMISSIONERS  
416 North State Street  
Jackson, Mississippi 39201

WATER WELL DRILLERS LOG

2/11 1980  
date well completed

Dyer  
firm name

Washington  
county well located

LANDOWNER:

LEO WILLIAMS

Hallandale, MS.  
(mailing address)

WELL LOCATION:

sec. 14 T. 15N R. 2 E  
8 miles W of Hallandale  
(distance) (direction) (nearest town)

WELL PURPOSE: Irrigation  
(home, irrigation, municipal, industrial)

WELL COMPLETION DATA:

- (1) diameter (inches) 16"
- (2) total depth (feet) 113'
- (3) static water level (feet) 20' below top of ground
- (4) casing 16" (material), 113' (depth)  
16" if telescope see back. (size)
- (5) screen 40' (length), 73' (depth to top)  
16" (size), Steel (material)
- (6) pump 60 (HP), 3000 (yield gpm)  
electric (type power)
- (7) electric log (yes or no)
- (8) how well bottom plugged plate

description of formations encountered


CODED

from

to

Clay	0	20
fine sand	20	28
sand	28	45
sand & gravel	45	113


CODED

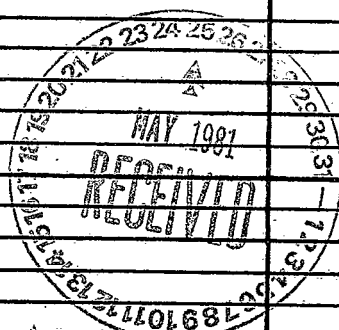

DRILLERS REMARKS:

If well telescopes please sketch and show depths.

GROUND LEVEL

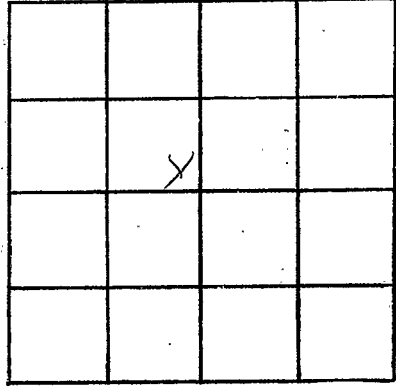

SECTION 14

Please indicate well location X.

ADDITIONAL INFORMATION

If more than one screen, show locations of each on sketch.