

Washington
 047
 3-12-80

MISSISSIPPI
 BOARD OF WATER COMMISSIONERS
 416 North State Street
 Jackson, Mississippi 39201

WATER WELL DRILLERS LOG

3/12 1980 Dyer Washington
 date well completed firm name county well located

LANDOWNER:
 SIC
 BOE WILLIS
 Glen Allen, MS.
 (mailing address)

description of formations encountered	CODED	from	to
Clay		0	28
Fine Sand		28	38
Sand		38	48
Sand & Gravel		48	113

WELL LOCATION:
 sec. 34 T. 15 N. R. 7 E. S. 5 W.
 4 miles east of Glen Allen
 (distance) (direction) (nearest town)

WELL PURPOSE: Irrigation
 (home, irrigation, municipal, industrial)


- WELL COMPLETION DATA:
- (1) diameter (inches) 16"
 - (2) total depth (feet) 113'
 - (3) static water level (feet) 20' below top of ground.
 - (4) casing Steel, 113' (material) (depth)
 16" if telescope see back. (size)
 - (5) screen 40', 73' (length) (depth to top)
 16" Steel (size) (material)
 - (6) pump 60 3000 (HP) (yield gpm)
 Diesel (type power)
 - (7) electric log (yes or no)
 (organization running log)
 - (8) how well bottom plugged plate

CODED

DRILLERS REMARKS:

If well telescopes please sketch and show depths.

GROUND LEVEL

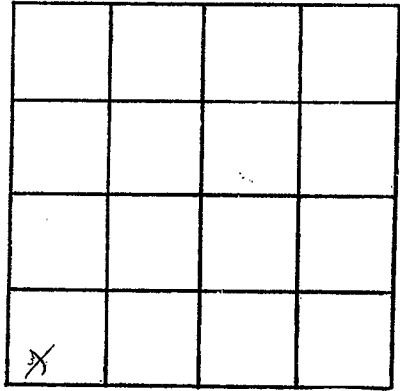

SECTION 34

Please indicate well location X.

ADDITIONAL INFORMATION

If more than one screen,
show locations of each on sketch.