

WATER WELL DRILLERS LOG

3255
#1

Washington
48
10-22-80

10/22 1980
date well completed

Dyer
firm name

Washington
county well located

LANDOWNER:

LEO WILLIAMS

Hollandale, MS
(mailing address)

WELL LOCATION:

sec. 20 T 15 N R 7 E
6 miles W of Hollandale
(distance) (direction) (nearest town)

WELL PURPOSE: Irrigation
(home, irrigation, municipal, industrial)

WELL COMPLETION DATA:

- (1) diameter (inches) 16
- (2) total depth (feet) 113'
- (3) static water level (feet) 22' below top of ground.
- (4) casing Steel 113' (material) (depth)
- 16" if telescope case back. (size)
- (5) screen 40' 73' (length) (depth to top)
- 16" Steel (size) (material)
- (6) pump 60 7000 (HP) (yield gpm)
- Electric (type power)
- (7) electric log (yes or no)
- (organization running log)
- (8) how well bottom plugged Slate


description of formations encountered

CODED


from to

Clay	0	28
Fine sand	28	38
Coarse sand	38	70
Sand + gravel	70	113

CODED

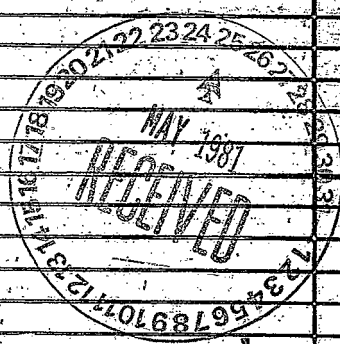

DRILLERS REMARKS:

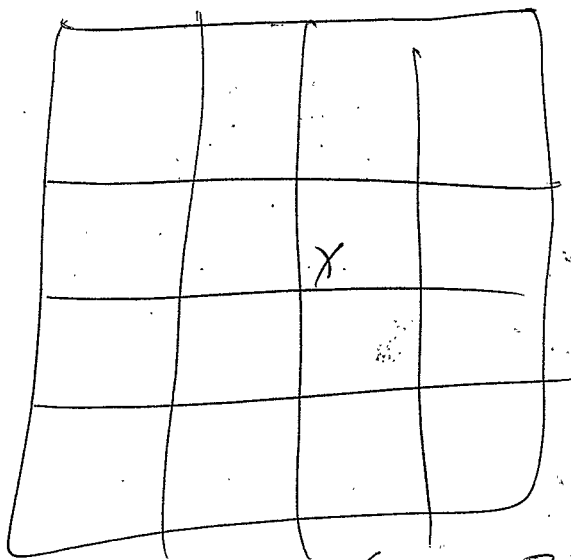

See 20