

**MISSISSIPPI DEPARTMENT OF NATURAL RESOURCES**  
 Bureau of Land and Water Resources  
 Southport Mall  
 P.O. Box 10631  
 Jackson, Mississippi 39209  
**WATER WELL DRILLERS LOG**

Washington  
Q49  
12-8-80

3255

12/8 1980 Dyer Washington  
 date well completed      firm name      county well located

**LANDOWNER:**  
Leo Williams  
Holladale, MS.  
 (mailing address)

**CODED**


description of formations encountered	from	to
<u>Clay</u>	<u>0</u>	<u>21</u>
<u>Fine sand + Clay</u>	<u>25</u>	<u>49</u>
<u>Sand</u>	<u>49</u>	<u>65</u>
<u>Sand + gravel</u>	<u>65</u>	<u>98</u>

**WELL LOCATION:**  
 sec. 21 T. 18 N. R. 7 E. S. 1 W.  
3 miles W of Percy  
 (distance) (direction) (nearest town)

**WELL PURPOSE:** Drinking  
 (home, irrigation, municipal, industrial)

- WELL COMPLETION DATA:**
- diameter (inches) 16"
  - total depth (feet) 98'
  - static water level (feet) 21' below above top of ground.
  - casing Steel 98'  
 (material) (depth)  
16" If telescopes see back.  
 (size)
  - screen 40' 58'  
 (length) (depth to top)  
16" Steel  
 (size) (material)
  - pump 60 300  
 (HP) (yield gpm)  
electric  
 (type power)
  - electric log (yes or no) \_\_\_\_\_  
 (organization running log) \_\_\_\_\_
  - how well bottom plugged plate

**CODED**

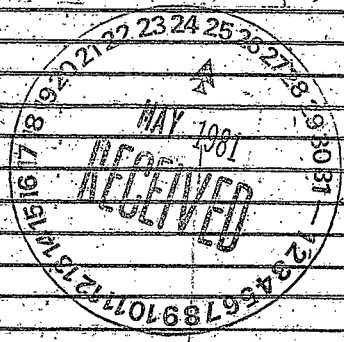

**DRILLERS REMARKS:**

			X

See 21 ~~10~~