

MISSISSIPPI DEPARTMENT OF NATURAL RESOURCES

Bureau of Land and Water Resources

Southport Mall

P.O. Box 10631

Jackson, Mississippi 39209

WATER WELL DRILLERS LOG

CODED

WASH.  
 052  
 4-6-81

April 06, 1981 date/well completed  
 Larry's Well & Pump Co. firm name  
 Washington county well located

LANDOWNER: <u>H. T. Cochran</u>	description of formations encountered	from	to
<u>Holladay, Mo.</u> (mailing address)	CLAY	0	30
	FINE + MED SAND	30	60
	MED + COARSE SAND	60	106
WELL LOCATION: sec. <u>6</u> T. <u>15</u> N. R. <u>7</u> W. <u>6</u> miles <u>W</u> of <u>Holladay</u> (distance) (direction) (nearest town)			
WELL PURPOSE: (home, irrigation, municipal, industrial)			
WELL COMPLETION DATA:			
(1) diameter (inches) <u>16"</u>			
(2) total depth (feet) <u>106'</u>			
(3) static water level (feet) <u>23</u> below top of ground.			
(4) casing <u>Steel</u> , <u>66'</u> (material) (depth) (size) If telescope see back.			
(5) screen <u>40'</u> , <u>66'</u> (length) (depth to top) <u>16"</u> , <u>Steel</u> (size) (material)			
(6) pump <u>60</u> , <u>3000</u> (HP) (yield gpm) (type power)			
(7) electric log <u>No</u> (yes or no) (organization running log)			
(8) how well bottom plugged <u>Steel Plate</u>			
DRILLERS REMARKS:			

CODED


DEPT. OF NATURAL RESOURCES  
 BUREAU OF LAND & WATER RESOURCES

OCT 19 1981

RECEIVED

If well telescopes please sketch and show depths.

GROUND LEVEL

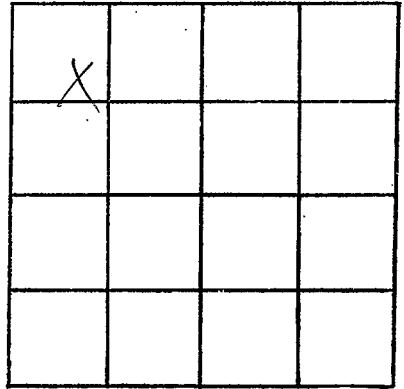

SECTION 6

Please indicate well location X.

ADDITIONAL INFORMATION

If more than one screen, show locations of each on sketch.