

MISSISSIPPI DEPARTMENT OF NATURAL RESOURCES

Bureau of Land and Water Resources

Southport Mall

P.O. Box 10631

Jackson, Mississippi 39209

WATER WELL DRILLERS LOG

CODED  
12/11/81

WASHINGTON  
\$54  
12-9-81

12-9 1981 Irrigation Supply Co. Inc. Washington  
date well completed firm name county well located

LANDOWNER: Hank Bardine  
40 BURDINE MATERIALS  
SOUTH RACEWAY ROAD  
GREENVILLE, MS 38701  
(mailing address)

WELL LOCATION:  
sec 5 T 15 N R 7  
5 miles west of Hollandale  
(distance) (direction) (nearest town)

WELL PURPOSE:  
(home, irrigation, municipal, industrial)

WELL COMPLETION DATA:

- (1) diameter (inches) 12"
- (2) total depth (feet) 120'
- (3) static water level (feet) 20' <sup>below</sup> above top of ground.
- (4) casing Steel, 80'  
(material) (depth)  
12" If telescope see back.  
(size)
- (5) screen 40' 80'  
(length) (depth to top)  
12" steel  
(size) (material)
- (6) pump 60 1500  
(HP) (yield gpm)  
Diesel  
(type power)
- (7) electric log (yes or no)  
(organization running log)
- (8) how well bottom plugged welded  
plate

description of fomations encountered	from	to
<u>Topsoil + Clay</u>	<u>0</u>	<u>30</u>
<u>Fine Grey Sand</u>	<u>30</u>	<u>50</u>
<u>Med. Course grey Sand</u>	<u>50</u>	<u>60</u>
<u>Fine grey Sand</u>	<u>60</u>	<u>80</u>
<u>Med course grey Sand</u>	<u>80</u>	<u>100</u>
<u>Course grey sand</u>	<u>100</u>	<u>110</u>
<u>course greysand + gravel</u>	<u>110</u>	<u>120</u>
<u>No Bottom</u>		

DEPT. OF NATURAL RESOURCES  
BUREAU OF LAND & WATER RESOURCES


DEC 11 1981

RECEIVED

DRILLERS REMARKS: Top 10 or  
12' needs surface  
casing

If well telescopes please sketch and show depths.

GROUND LEVEL

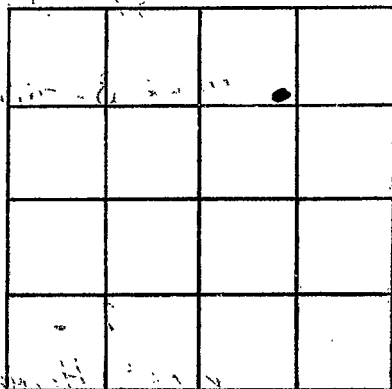

SECTION 5

Please indicate well location X.

ADDITIONAL INFORMATION

RECEIVED

81 DEC 11 A 8: 58

If more than one screen, show locations of each on sketch.