

MISSISSIPPI DEPARTMENT OF NATURAL RESOURCES

Bureau of Land and Water Resources

Southport Mall

P.O. Box 10631

Jackson, Mississippi 39209

WATER WELL DRILLERS LOG

CODED

WASHINGTON
 53
 CL-1857
 5-11-81

5-11-81 5-1281 19

Layne-Central Company

Washington

date well completed

firm name

county well located

LANDOWNER:

Edward Shackelford

Hollandale, MS

(mailing address)

WELL LOCATION:

sec 12 T 15 N R 2 E
 1 miles W of Hollandale
 (distance) (direction) (nearest town)

description of formations encountered

from

to

Clay	0	22
Coarse sand	22	32
Coarse sand	32	42
Coarse sand	42	52
Coarse sand PG	52	62
Coarse sand PG	62	72
Coarse sand gravel	72	82
Coarse sand gravel	82	102
Coarse sand gravel	102	118

WELL PURPOSE: irrigation

(home, irrigation, municipal, industrial)

WELL COMPLETION DATA:

- (1) diameter (inches) 32"
- (2) total depth (feet) 118'
- (3) static water level (feet) 28' below top of ground
- (4) casing Steel 68' (material), (depth)
 16" (size) if telescope see back.
- (5) screen 50' 68' (length), (depth to top)
 16" (size), Steel (material)
- (6) pump 50 2400 (HP), (yield gpm)
 ELEC. (type power)
- (7) electric log no (yes or no)

CODED

(organization running log)

(8) how well bottom plugged st. plate

DRILLERS REMARKS:


DEPT. OF NATURAL RESOURCES
 BUREAU OF LAND & WATER RESOURCES

OCT 20 1991

RECEIVED

If well telescopes please sketch and show depths.

GROUND LEVEL

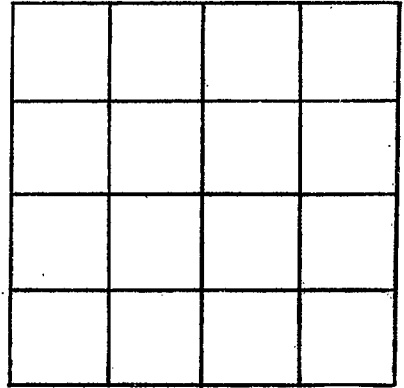

SECTION _____

Please indicate well location X.

ADDITIONAL INFORMATION

If more than one screen,
show locations of each on sketch.