

MISSISSIPPI DEPARTMENT OF NATURAL RESOURCES

Bureau of Land and Water Resources

Southport Mall

P.O. Box 10631

Jackson, Mississippi 39209

WATER WELL DRILLERS LOG

Washington  
Q 57  
3/10/82

**CODED**

3-10 19 82 Ogden Well  
 date well completed firm name

Washington  
 county well located

LANDOWNER: Wells Farms

description of formations encountered

from

to

(mailing address)

WELL LOCATION:

sec. 29 T. 15 (N) R. 7 (E)  
5 miles SW of Belvedere  
 (distance) (direction) (nearest town)

WELL PURPOSE: irrigation  
 (home, irrigation, municipal, industrial)

WELL COMPLETION DATA:

- (1) diameter (inches) 16
- (2) total depth (feet) 113
- (3) static water level (feet) 18 below above top of ground.
- (4) casing Steel, 23 (material), (depth), 16" (size) if telescope see back.
- (5) screen 40 (length), (depth to top) 16 (size), Mild Steel (material)
- (6) pump 60 (HP), 3000 (yield gpm), Direct (type power)
- (7) electric log No (yes or no)
- (organization running log)
- (8) how well bottom plugged Plate

DRILLERS REMARKS:

DEPT. OF NATURAL RESOURCES  
 BUREAU OF LAND & WATER RESOURCES

MAY 19 1982


**RECEIVED**

**CODED**

Clay	0	15
Clay	13	27
Clay	28	33
Clay	38	43
Sand	43	53
G Sand	53	63
G Sand	62	73
G Sand	72	83
G Sand	83	93
Small Gravel	93	103
Sand & Gravel	103	113

If well telescopes please sketch and show depths.

GROUND LEVEL

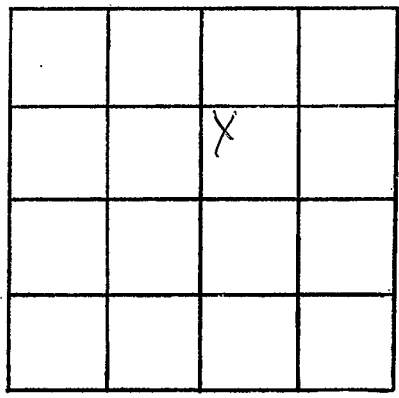

SECTION 29

Please indicate well location X.

ADDITIONAL INFORMATION

A series of horizontal lines for writing additional information, starting below the 'ADDITIONAL INFORMATION' header and extending to the bottom of the page.

If more than one screen, show locations of each on sketch.