

MISSISSIPPI DEPARTMENT OF NATURAL RESOURCES
Bureau of Land and Water Resources
 Southport Mall
 P.O. Box 10631
 Jackson, Mississippi 39209
WATER WELL DRILLERS LOG

CODED

Washington
 CL-2087 Q58
4/14/82

4-14 19 82 LAYNE CENTRAL CO. WASHINGTON
 date well completed firm name county well located

LANDOWNER:	description of formations encountered	from	to
SHACKLEFORD FARMS			
HOLLANDALE, MS	fine sand	24	32
(mailing address)	med. coarse sand	32	42
	fine sand	42	57
WELL LOCATION:	coarse sand	57	62
sec. 12 T 15 N R 7 W	" "	62	92
1 miles W of Hollandale	" " & gravel	92	118
(distance) (direction) (nearest town)	clay	118	119
WELL PURPOSE: (home, irrigation, municipal, industrial)			
WELL COMPLETION DATA:			
(1) diameter (inches) 32"			
(2) total depth (feet) 118'			
(3) static water level (feet) 26' below top of ground.			
(4) casing steel 68' (material) (depth)			
16" (size) if telescope see back.			
(5) screen 50' 68' (length) (depth to top)			
16" (size) st. steel (material)			
(6) pump 40 2000 (HP) (yield gpm)			
electric (type power)			
(7) electric log no (yes or no)			
(organization running log)			
(8) how well bottom plugged st. plate			

CODED


DRILLERS REMARKS:

DEPT. OF NATURAL RESOURCES
 BUREAU OF LAND & WATER RESOURCES

JUN 24 1982
RECEIVED

If well telescopes please sketch and show depths.

GROUND LEVEL

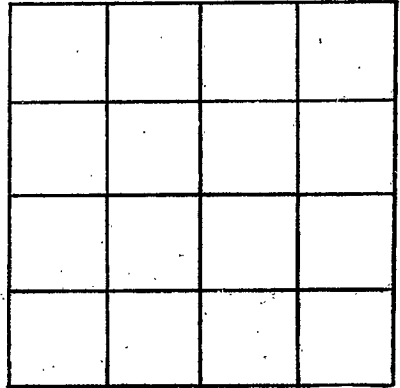

SECTION _____

Please indicate well location X.

ADDITIONAL INFORMATION

If more than one screen,
show locations of each on sketch.