

MISSISSIPPI DEPARTMENT OF NATURAL RESOURCES

Bureau of Land and Water Resources

Southport Mall

P.O. Box 10631

Jackson, Mississippi 39209

WATER WELL DRILLERS LOG

CODED

Washington
Q 59
9/2/82

2 Sep 1982 date well completed Coppage Drilling Inc firm name Washington county well located

LANDOWNER: Hank Burdine
Greenville, MS 38701
 (mailing address)

description of formations encountered	from	to
<u>Clay</u>	<u>0</u>	<u>50</u>
<u>Fine Sand</u>	<u>50</u>	<u>60</u>
<u>Coarse Sand</u>	<u>60</u>	<u>75</u>
<u>Gravel</u>	<u>75</u>	<u>98</u>

WELL LOCATION:
 sec. 8 T. 15 N R. 7 E
5 miles West of Hollandale
 (distance) (direction) (nearest town)

WELL PURPOSE: Irrigation
 (home, irrigation, municipal, industrial)

CODED

WELL COMPLETION DATA:

(1) diameter (inches) 1 1/2
 (2) total depth (feet) 100 98
 (3) static water level (feet) 25 below top of ground.
 (4) casing PVC 50' 58
 (material) (depth)
6" if telescope see back.
 (size)
 (5) screen 40 60' 58
 (length) (depth to top)
6 PVC
 (size) (material)
 (6) pump 7 1/2 400
 (HP) (yield gpm)
 (type power)
 (7) electric log no
 (yes or no)
no
 (organization running log)
 (8) how well bottom plugged PVC
end cap


DRILLERS REMARKS: Pump set @ 40

DEPT. OF NATURAL RESOURCES
 BUREAU OF LAND & WATER RESOURCES

SEP 23 1982
 RECEIVED

If well telescopes please
sketch and show depths.

GROUND LEVEL

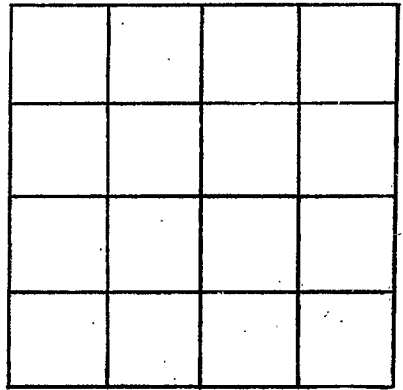

SECTION _____

Please indicate well location X.

ADDITIONAL INFORMATION

If more than one screen,
show locations of each on sketch.