

MISSISSIPPI DEPARTMENT OF NATURAL RESOURCES

Bureau of Land and Water Resources

Southport Mall

P.O. Box 10631

Jackson, Mississippi 39209

WATER WELL DRILLERS LOG

CODED

Washington
Q 120
3182

date well completed 19

Pyer Well
 firm name

Washington
Stamper
 county well located

LANDOWNER: Farm Fresh

description of formations encountered

from

to

Hollandale, Miss.
 (mailing address)

<u>Clay</u>	<u>0</u>	<u>38</u>
<u>Fine sand</u>	<u>38</u>	<u>65</u>
<u>Fine sand & gravel</u>	<u>65</u>	<u>89</u>
<u>Fine Sand</u>	<u>89</u>	<u>108</u>
<u>Small Gravel</u>	<u>108</u>	<u>123</u>

WELL LOCATION:

sec. 18 T. 15 N. R. 7 E.
5 miles W of Hollandale
 (distance) (direction) (nearest town)

WELL PURPOSE:
 (home, irrigation, municipal, industrial)

WELL COMPLETION DATA:

- (1) diameter (inches) 16"
- (2) total depth (feet) 123
- (3) static water level (feet) 26 below above top of ground.
- (4) casing mild steel, 86, 83
 (material) (depth)
- 16 if telescope see back.
 (size)
- (5) screen 40, 16, mild steel
 (length) (depth to top) (size) (material)
- (6) pump 60, 3000
 (HP) (yield gpm)
- electric
 (type power)
- (7) electric log no
 (yes or no)
- no
 (organization running log)
- (8) how well bottom plugged plate

CODED

DEPT. OF NATURAL RESOURCES
 BUREAU OF LAND & WATER RESOURCES


SEP 30 1982

RECEIVED

DRILLERS REMARKS:

If well telescopes please sketch and show depths.

GROUND LEVEL

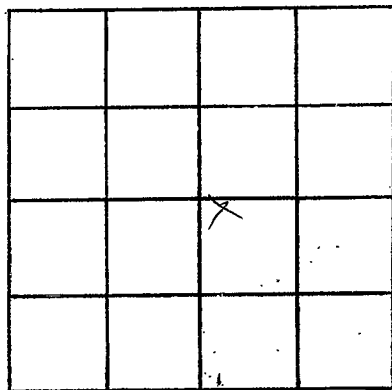

SECTION 18

Please indicate well location X.

ADDITIONAL INFORMATION

If more than one screen, show locations of each on sketch.