

MISSISSIPPI DEPARTMENT OF NATURAL RESOURCES
 Bureau of Land and Water Resources
 Southport Mall
 P.O. Box 10631

CODED

Jackson, Mississippi 39209
WATER WELL DRILLERS LOG

062
Washington
9-10-83

9-10
 date well completed

1983 Larry's Pump & Well
 firm name

Sevel Washington
Humphreys
 county well located

LANDOWNER:
Huber Farm Services
Hollandale, Miss.
 (mailing address)

description of formations encountered	from to	
<u>CLAY</u>	<u>0</u>	<u>18</u>
<u>FINE SAND</u>	<u>18</u>	<u>35</u>
<u>SAND GRAVEL</u>	<u>35</u>	<u>120</u>

WELL LOCATION:
 sec. 14 T. 5 N. R. 7 E.
3 miles SW of Hollandale
 (distance) (direction) (nearest town)

WELL PURPOSE:
 (home, irrigation, municipal, industrial)

WELL COMPLETION DATA:

(1) diameter (inches) 16"

(2) total depth (feet) 120'

(3) static water level (feet) 18' below top of ground.

(4) casing PVC, 80'
 (material) (depth)
 (size) if telescope see back.

(5) screen 40', 80'
 (length) (depth to top)
16", PVC
 (size) (material)

(6) pump 50, 3000
 (HP) (yield gpm)
electric
 (type power)

(7) electric log no
 (yes or no)
 (organization running log)

(8) how well bottom plugged Tap

DEPT. OF NATURAL RESOURCES
 BUREAU OF LAND & WATER RESOURCES


0073 1983

RECEIVED

DRILLERS REMARKS:

If well telescopes please sketch and show depths.

GROUND LEVEL

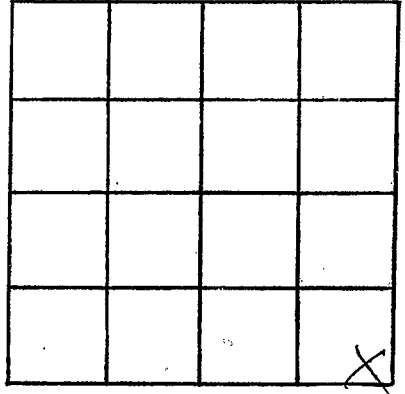

SECTION 14

Please indicate well location X.

ADDITIONAL INFORMATION

If more than one screen,
show locations of each on sketch.