

WASHINGTON
 Q 63

MISSISSIPPI DEPARTMENT OF NATURAL RESOURCES
 Bureau of Land and Water Resources
 Southport Mall
 P.O. Box 10631
 Jackson, Mississippi 39209
 WATER WELL DRILLERS LOG

CODED

4-16-85 19 IRRIGATION EQUIPMENT WASHINGTON
 date well completed firm name county well located

LANDOWNER: Longwood Farms
 Rt. 1, Box L
 Hollandale, MS 38748
 (mailing address)

description of formations encountered	from	to
Clay	0	15
fine sand	15	65
Coarse sand	65	110
Coarse sand / pea gravel	110	120

WELL LOCATION:
 sec. 15 T 15 N S R 7 E W
 5 miles West of Hollandale
 (distance) (direction) (nearest town)

WELL PURPOSE: Irrigation
 (home, irrigation, municipal, industrial)

- WELL COMPLETION DATA:
- (1) diameter (inches) 16"
 - (2) total depth (feet) 120
 - (3) static water level (feet) 9 below above top of ground.
 - (4) casing steel 80' (material) (depth)
 - (size) if telescope see back.
 - (5) screen 40' 80' (length) (depth to top)
 16" steel (size) (material)
 - (6) pump 40 2000 (HP) (yield gpm)
 Diesel (type power)
 - (7) electric log NO (yes or no)
 (organization running log)
 - (8) how well bottom plugged steel plate

CODED


RECEIVED
 APR 23 1985

Department of Natural Resources
 Bureau of Land & Water Resources

DRILLERS REMARKS:

If well telescopes please sketch and show depths.

GROUND LEVEL

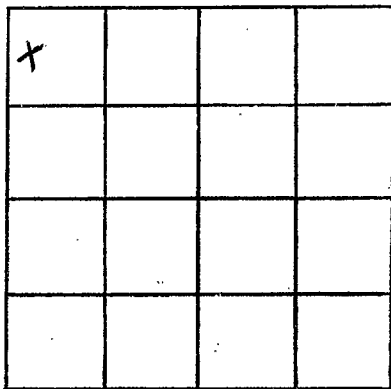

SECTION 15

Please indicate well location X.

ADDITIONAL INFORMATION

If more than one screen,
show locations of each on sketch.