

MISSISSIPPI DEPARTMENT OF NATURAL RESOURCES <sup>P</sup>

Bureau of Land and Water Resources

Southport Mall

P.O. Box 10631

Jackson, Mississippi 39209

WATER WELL DRILLERS LOG

CODED

WASHINGTON  
 64  
 4-17-85

April 17 1985 Larry's well & pump Washington  
 date well completed firm name county well located

LANDOWNER: Rusty Willis  
 Hollandale  
 (mailing address)

description of formations encountered	from	to
clay	0	22
Fine sand	22	53
COARSE sand & gravel	53	100

WELL LOCATION:  
 sec. 32 T. 15 N. R. 7 E.  
 8 S. 7 W.  
 8 miles S4 of Hollandale  
 (distance) (direction) (nearest town)

CODED

WELL PURPOSE:  
 (home, irrigation, municipal, industrial)


WELL COMPLETION DATA:  
 (1) diameter (inches) 16"  
 (2) total depth (feet) 100'  
 (3) static water level (feet) 24' below top of ground.  
 (4) casing Steel, 60' (material) (depth)  
 (size) If telescope see back.  
 (5) screen 40' 60' (length) (depth to top)  
 16" Steel (size) (material)  
 (6) pump 60 1,200 (HP) (yield gpm)  
 ASI (type power)  
 (7) electric log No (yes or no)  
 (organization running log)  
 (8) how well bottom plugged Steel Plate

RECEIVED  
 JUN 17 1986  
 Department of Natural Resources  
 Bureau of Land & Water Resources

DRILLERS REMARKS:

If well telescopes please  
sketch and show depths.

GROUND LEVEL

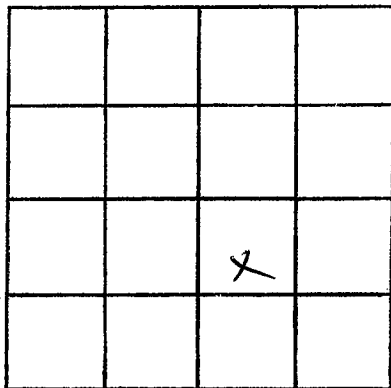

SECTION 32

Please indicate well location X.

ADDITIONAL INFORMATION

If more than one screen,  
show locations of each on sketch.