

MISSISSIPPI DEPARTMENT OF NATURAL RESOURCES

Bureau of Land and Water Resources

Southport Mall

P.O. Box 10631

Jackson, Mississippi 39209

WATER WELL DRILLERS LOG

WASHINGTON
8074
Φ 66

Coded

10-29 date well completed 1987 Dyer Well firm name Washington county well located

LANDOWNER:	description of formations encountered	from	to
W & S Farms	CLAY	0	28
RT 1 Box 380	Fine Sand	28	45
HOLLANDALE Ms.	M Sand & Gravel	45	62
(miling address)	Fine Sand	62	73
WELL LOCATION:	M Sand & Gravel	73	76
sec 28 T 15 N R 7 E	Sand & Gravel	76	90
10 miles W of Hollandale	Fine Sand	90	94
(distance) (direction) (nearest town)	Sand & Gravel	94	108
WELL PURPOSE: Irrigation			
(home, irrigation, municipal, industrial)			
WELL COMPLETION DATA:			
(1) diameter (inches) 16"			
(2) total depth (feet) 108'			
(3) static water level (feet) _____ below above top of ground.			
(4) casing Steel (material), (depth), 16" (size) if telescope see back.			
(5) screen 40' (length), (depth to top) 16" (size), (material)			
(6) pump 40 (HP), (yield gpm) Engine (type power)			
(7) electric log No (yes or no) Norve (organization running log)			
(8) how well bottom plugged Plate			
DRILLERS REMARKS:			


RECEIVED

EFFR 01 1988

Department of Natural Resources
Bureau of Land & Water Resources

If well telescopes please
sketch and show depths.

GROUND LEVEL

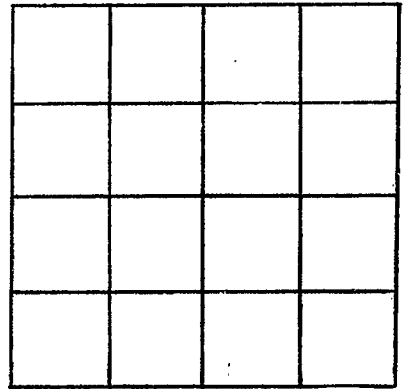

SECTION _____

Please indicate well location X.

ADDITIONAL INFORMATION

If more than one screen,
show locations of each on sketch.