

MISSISSIPPI DEPARTMENT OF NATURAL RESOURCES

Bureau of Land and Water Resources

Southport Mall

P.O. Box 10631

Jackson, Mississippi 39209

WATER WELL DRILLERS LOG

WASHINGTON  
 67

CODED

5-16 1988  
 date well completed

Schultz Drilling  
 firm name

Washington  
 county well located

LANDOWNER: <u>Earl &amp; Coicy</u>	description of formations encountered	from	to
<u>Hwy 12 - Box 235</u> <u>Hollandale MS 38748</u> (mailing address)			
	CLAY	0	30
	Medium SAND	30	57
	COARSE SAND	57	80
	SAND + PEA GRAVEL	80	112

WELL LOCATION:  
 sec. 20 T 15 N R 7 E  
S miles W of Hollandale  
 (distance) (direction) (nearest town)

WELL PURPOSE: IRRIGATION  
 (home, irrigation, municipal, industrial)

- WELL COMPLETION DATA:
- (1) diameter (inches) 12"
  - (2) total depth (feet) 112'
  - (3) static water level (feet) 33' below/above top of ground.
  - (4) casing PVC 72'  
(material) (depth)
  - \_\_\_\_\_ If telescope see back.  
(size)
  - (5) screen 40 72  
(length) (depth to top)
  - 12 PVC  
(size) (material)
  - (6) pump 40 1500  
(HP) (yield gpm)
  - pto  
(type power)
  - (7) electric log NO  
(yes or no)
  - \_\_\_\_\_ (organization running log)
  - (8) how well bottom plugged CAP

RECEIVED


JUN 16 1988

Department of Natural Resources  
 Bureau of Land & Water Resources

DRILLERS REMARKS:

If well telescopes please sketch and show depths:

GROUND LEVEL

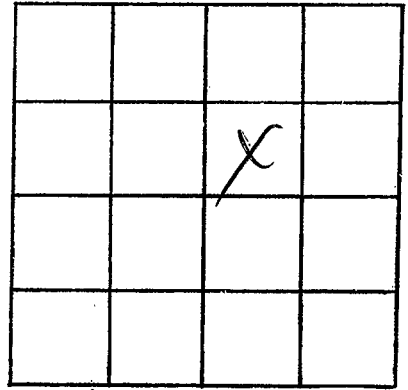

SECTION 20

Please indicate well location X.

ADDITIONAL INFORMATION

If more than one screen,  
show locations of each on sketch.