

MISSISSIPPI DEPARTMENT OF NATURAL RESOURCES

Bureau of Land and Water Resources

Southport Mall

P.O. Box 10631

Jackson, Mississippi 39209

WATER WELL DRILLERS LOG

TEP CODED  
11343-RES-  
082488  
Φ 68

6-28-88 Dyer Well Washington  
date well completed firm name county well located

LANDOWNER

Lakeland Pitt

description of formations encountered

from

to

Rt 1 Box 380

Hollandale Ms.  
(mailing address)

<u>Clay</u>	<u>0</u>	<u>28</u>
<u>fine sand</u>	<u>28</u>	<u>45</u>
<u>7 Sand &amp; Gravel</u>	<u>45</u>	<u>65</u>
<u>13 Sand &amp; Gravel</u>	<u>65</u>	<u>70</u>
<u>7 Sand &amp; Gravel</u>	<u>70</u>	<u>85</u>
<u>13 Sand &amp; Gravel</u>	<u>85</u>	<u>98</u>
<u>Sand &amp; Gravel</u>	<u>98</u>	<u>115</u>
<u>7 Sand &amp; Gravel</u>	<u>115</u>	<u>120</u>

WELL LOCATION:

sec 30 T 15 N R 7 E  
10 miles W of Hollandale  
(distance) (direction) (nearest town)

WELL PURPOSE:

Irrigation  
(home, irrigation, municipal, industrial)

WELL COMPLETION DATA:

- (1) diameter (inches) 16"
- (2) total depth (feet) 120'
- (3) static water level (feet) \_\_\_\_\_ below  
top of ground above
- (4) casing steel  
(material) (depth) \_\_\_\_\_  
16" if telescope see back.  
(size)
- (5) screen 40'  
(length) (depth to top) \_\_\_\_\_  
16"  
(size) (material)
- (6) pump 60  
(HP) (yield gpm) \_\_\_\_\_  
Gear  
(type power)
- (7) electric log No  
(yes or no)  
None  
(organization running log)
- (8) how well bottom plugged Plate

RECEIVED


JUL 11 1988

Department of Natural Resources  
Bureau of Land & Water Resources

DRILLERS REMARKS:

If well telescopes please  
sketch and show depths.

GROUND LEVEL

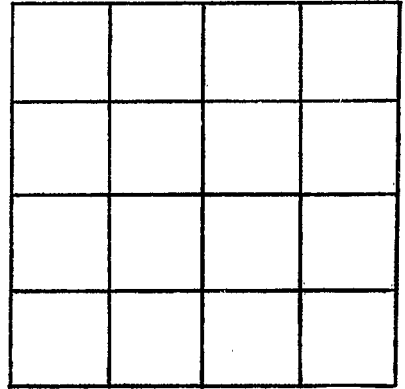

SECTION \_\_\_\_\_

Please indicate well location X.

ADDITIONAL INFORMATION

If more than one screen,  
show locations of each on sketch.