

MISSISSIPPI DEPARTMENT OF NATURAL RESOURCES

Bureau of Land and Water Resources

COUNTY WELL LOCATED
Washington

WELL NUMBER **Φ 71** CODED

DATE WELL COMPLETED
3-19-90

166A02C

PERMIT NUMBER

NAME OF DRILLING FIRM
Dyn Well

CODED

P.O. Box 10631
Jackson, Mississippi 39209
WATER WELL DRILLERS LOG

NAME & MAILING ADDRESS OF LANDOWNER
Lake Land Pkt
Rt 1 Box 380
Hollandale, Ms. 38748

WELL LOCATION: SEC **30** TOWNSHIP **15** RANGE **7**

DISTANCE _____ MILES _____ OF _____ NEAREST TOWN

OTHER LANDMARK _____

WELL PURPOSE: Home Irrigation Municipal, Industrial, Fish Pond, etc.

PUMP DATA

PUMP TYPE (Circle One):
Submersible, Turbine Jet Flowing Well,
Other (Describe) _____

POWER TYPE (Circle One):
Electric, Tractor, Diesel Gasoline, Butane,
Other (Describe) _____ H/P _____

Pump Capacity (GPM) **2000** No. of Stages **2** Setting Depth **70** FT.

PUMP TEST
Well yielded _____ GPM with
a drawdown of _____ ft.
after _____ hours of pumping

WELL DATA

Well Depth 112'	Casing Diameter (In.) 16"	Casing Length (Ft.) 72'
Type of Casing steel	Hole Depth	Depth to Static Water Level

TYPE OF COMPLETION: (Circle One or More):
Gravel Packed Underreamed, Telescoped,
Natural Development, Open Hole, Other

Top of Lap Pipe or Reduction in Casing

FEET IF TELESCOPED OR MORE THAN ONE SCREEN: USE BACK PAGE

LOG DATA

TYPE OF LOG RUN (Circle One):
Electric, Gamma Ray, Density, Sonic, Neutron,
Other (Describe) No Log Run

Name of Organization Running Log
None

SCREEN DATA

Diameter - Inches 16"	Length - Feet 40'	Slot Size - Inches .030
Screen Type Wire Wrap	Depth to Bottom - Feet	

GEOLOGIC DATA (Office Use Only)

Surface Elev.	Geologic Unit	Unit Thickness	Depth to Top
Subs. SWL	Date	Analysis	Aquifer Test


Driller's Remarks

DESCRIPTION OF FORMATIONS ENCOUNTERED	FROM	TO	FORMATIONS (Continued)	FROM	TO
Clay	0	54	RECEIVED MAR 22 1990 Department of Natural Resources Bureau of Land & Water Resources		
Fine Sand	54	76			
Fine Sand + Gravel	76	98			
M. Sand + Gravel	98	106			
Sand + Gravel	106	112			

IF MORE SPACE IS NEEDED, USE BACK

If well telescopes please
sketch and show depths.

GROUND LEVEL

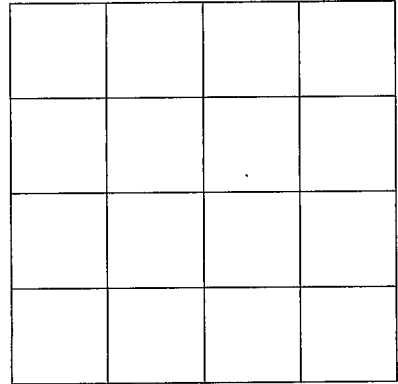

SECTION _____

Please indicate well location X.

ADDITIONAL INFORMATION

If more than one screen,
show location of each on sketch.