

WALKER

State Well Report

Part 1

Mississippi Department of Environmental Quality
Office of Land and Water Resources
P.O. Box 10631
Jackson, MS 39289-0631
(601)961-5210
(601)354-6938 (fax)

For Office Use Only:

Aquifer: _____
Well #: Q-123
L. S. Elevation: _____
E-log #: _____

County: WASHINGTON
Permit #: 6W43059
Driller: J. NEWCOME 0-773
Date drilling completed: 2-23-09

State Law requires that this report be prepared by the driller in detail and filed with the Department within 30 days of completion of drilling of the well.

| Well Owner Information | Well Location |
|---------------------------------------|--|
| Owner Name: <u>Reality Farms P+R.</u> | Latitude: <u>33° 06' 15"</u> Longitude: <u>90° 53' 57"</u> |
| Mailing Address: <u>PO Box 273</u> | Method of Lat/Long (circle one): Conventional Survey, |
| <u>Stoneville MS 38706</u> | USGS quad: <u>Hand-held GPS</u> Survey-grade GPS |
| City State Zip Code | <u>NW 1/4 SE 1/4 Sec 34 Twn 15N Rng 7W</u> |
| Telephone No. <u>(662) 822-0301</u> | Distance Direction Nearest Town |
| | <u>5 Miles S of HOLLANDALE</u> |

Well Data

Purpose of Well (circle one) Home Industrial Public Supply Irrigation Fish Culture Other: _____

Date well drilling started: 2-23-09 Date well drilling completed: 2-23-09

If flowing, method of flow regulation: Valve _____ Other (describe) _____

Static Water Level: _____ feet above or below (circle one) land surface Date measured: _____

Method of Measurement (circle one) steel tape electric tape air line other: _____

Hole depth: 113 Well depth: 110 Well grouted to a depth of 10 feet

Type of grout (circle one): Cement Bentonite Mix

Casing length: 70 feet Casing diameter: 16 inches Type of casing: PVC

Screen length: 40 feet Screen diameter: 16 inches Type of screen: PVC

Screen slot size: .050 inches Setting depth: From 70 feet to 110 feet

Type of completion (circle all applicable): Gravel packed Underreamed Telescoped Open hole Natural Development

Other (describe): _____

Top of lap pipe or reduction in casing: _____ feet. If telescoped or more than one screen, describe on back of page

Logs run (circle all applicable): No log run Electric Gamma Ray Density Sonic Neutron Other: _____

Name of organization running log(s): _____

I certify that the well was drilled, constructed, and completed in accordance with all applicable requirements of the Mississippi Department of Environmental Quality and/or the Mississippi Department of Health regulations and state laws.

JOHN NEWCOME
Print Name of Water Well Contractor and License No.

John Newcome RECEIVED
Signature of Water Well Contractor


MAR 16 2009

BY: OLWR

Q-123

If well telescopes please sketch below and show depths.


Ground Level

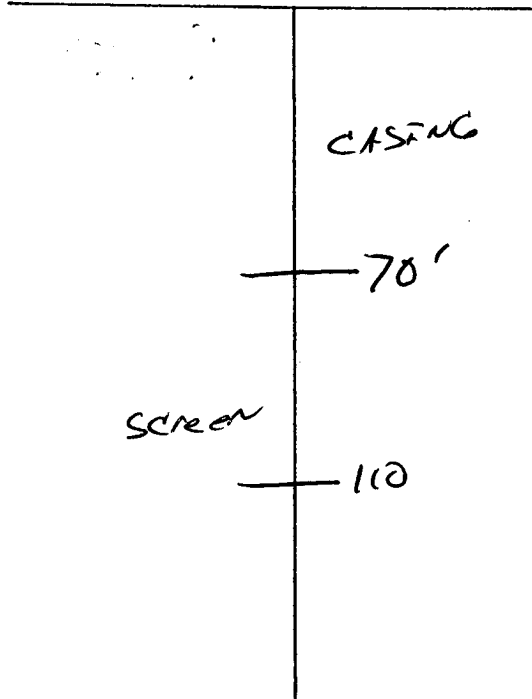

| Description of Formations Encountered | From | To |
|---------------------------------------|------|-----|
| TOP SOIL | 0 | 10 |
| MIX CLAY | 10 | 40 |
| FINE SAND | 40 | 70 |
| COARSE SAND | 70 | 110 |
| Gravel | 110 | 113 |
| | | |
| | | |
If more than one screen, show location of each on sketch

Sketch the property layout and include the following: 1) the well location; 2) any permanent structures on the property that may aid in locating the well; 3) any roads, power lines, or other items that may aid in locating the property and the well; 4) indicate direction.

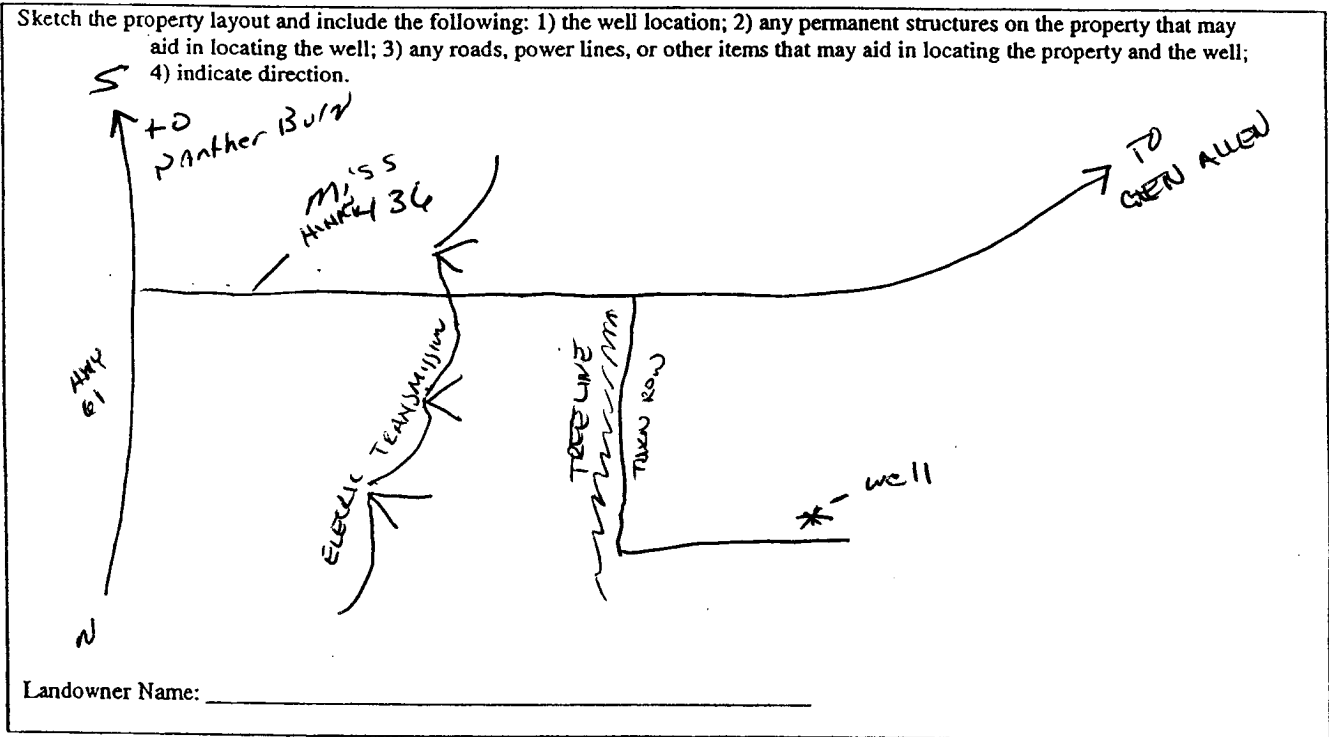


Signature of Water Well Contractor

STATE WELL REPORT

Part 2

Pump Installer's Completion Report
 Mississippi Department of Environmental Quality
 Office of Land and Water Resources
 P.O. Box 10631
 Jackson, MS 39289-0631
 (601)961-5210
 (601)354-6938 (fax)

For Office Use Only:

Aquifer: _____
 Well #: Q-123
 Elevation: _____

County: Washington
 Permit #: 6W43059
 Driller: J. Newcome
 Date completed: 2-23-09

This report should be prepared by the pump installer in detail and filed with the Department within 30 days of the installation of pump.

| Well Owner Information | Well Location |
|---------------------------------------|--|
| Owner Name: <u>Reality Farms P4r.</u> | Latitude: <u>33° 06' 15"</u> Longitude: <u>090° 53' 57"</u> |
| Mailing Address: <u>PO Box 273</u> | Method of Lat/Long (circle one): <input type="radio"/> Conventional Survey, <input checked="" type="radio"/> Hand-held GPS, <input type="radio"/> Survey-grade GPS |
| <u>Stonewille MS 38716</u> | USGS quad, <u>NW 1/4 SE 1/4 Sec 34 Twn 15N Rng 7W</u> |
| City State Zip Code | Distance Direction Nearest Town |
| Telephone No. <u>(662) 822-0301</u> | <u>5</u> Miles <u>S</u> of <u>Hollandale</u> |

| Pump Type Circle one | Power Type Circle one |
|--|--|
| Air Lift <input type="radio"/> Jet <input type="radio"/> Submersible | <input checked="" type="radio"/> Diesel Engine <input type="radio"/> Gasoline Engine <input type="radio"/> Natural Gas |
| Bucket <input type="radio"/> Piston <input checked="" type="radio"/> Turbine | Electric Motor <input type="radio"/> Hand <input type="radio"/> Tractor PTO |
| Centrifugal <input type="radio"/> Rotary <input type="radio"/> Flowing Well | Windmill <input type="radio"/> Other (specify): _____ |
| Other (specify): _____ | Horse Power Rating of Motor: <u>60</u> |
| Date Pump Installed: <u>2-23-09</u> | Setting Depth: <u>70</u> feet |
| Rated Pump Capacity: <u>2800</u> Gallons Per Minute | Number of Stages: <u>1</u> |

| Pump Test Data | Method of Measuring Water Level Circle one |
|---|---|
| Date Well Tested: _____ | <input type="radio"/> Air Line <input type="radio"/> Electric Measuring Line <input type="radio"/> Steel Tape |
| Static Water Level (A): <u>NO</u> Feet Below Land Surface | Other (specify): _____ |
| Pumping Water Level (B): _____ Feet Below Land Surface | For flowing well, measured shut in head: _____ feet |
| Drawdown [(B) - (A)]: <u>Test</u> Feet Below Land Surface | Well yielded _____ GPM with a drawdown of _____ feet after _____ hours of pumping |
| Test Pumping Rate: _____ Gallons Per Minute | |
| Duration of Pump Test (minimum 4 hours): _____ hours | |

I HEREBY CERTIFY that the above statements are true to the best of my knowledge.

Comp Rowe G-711P
 Print Name of Pump Installer and License No. (if applicable)

[Signature]
 Signature of Pump Installer

RECEIVED

MAR 16 2009
 BY: OLWR