County: WASHINGTON Permit #: GW43190 Driller: T. NEWCOME 0-773 Date drilling completed: 4-17-09

State Well Report

Part 1

Mississippi Department of Environmental Quality
Office of Land and Water Resources
P.O. Box 10631
Jackson, MS 39289-0631

(601)961-5210 (601)354-6938 (fax)

State Law requires that this report be prepared by the driller in detail and filed with the Department within 30 days of completion of drilling of the well.

Well Owner Information	Well Location	
	29 (72 (73	
Owner Name Opossum Ridge Planting	Latitude: 33 ° 10 3 / " Longitude: 670 12, 13"	
Mailing Address: 45 75 Lutleen	Method of Lat/Long (circle one): Conventional Survey,	
~	USGS quad Hand-held GPS Survey-grade GPS	
Hollandele, ms 38748 City State Zip Code	NE 14 NE 14 Sec 1 Twn 15 N Rng 7 W	
Hollandele, ms 38748	15 N Rule 14 Sec 1 IWA 25 Rule 197	
City State Zip Code	Direction Nearest Town	
Telephone No. (663) 833 - 5718	O Miles IN A HOLLANDALE	
Well Data		
Purpose of Well (circle one) Home Industrial Public Supply	Irrigation Fish Culture Other:	
Date well drilling started: 4-17-09 Date well drilling completed: 4-17-09		
If flowing, method of flow regulation: Valve Other (describe)		
Static Water Level:feet above or below (circle one) land surface Date measured:		
Method of Measurement (circle one) steel tape electric tape air line other:		
Hole depth: 110 Well depth: 113 Well grouted to a depth of 10 feet		
Type of grout (circle one): Cement Bentonite Mix		
Casing length: 70 feet Casing diameter: 14 inches Type of casing: PVC		
Screen length: 40 feet Screen diameter: 16 inches Type of screen: PKC		
Screen slot size: 050 inches Setting depth: From 60-90 feet to 100 - 110 feet		
Type of completion (circle all applicable): Cravel packed Underreamed Telescoped Open hole Natural Development		
Other (describe):		
Top of lap pipe or reduction in casing:feet. If telescoped or more than one screen, describe on back of page		
Logs run (circle all applicable): No log run Electric Gamma Ray Density Sonic Neutron Other:		
Name of organization running log(s):		
I certify that the well was drilled, constructed, and completed in accordance with all applicable requirements of the Mississippi		
Department of Environmental Quality and/or the Mississippi Department of Health regulations and state laws.		
18		
JOHN NEWCOME 0-773	<oh nowcoul<="" td=""></oh>	
Print Name of Water Well Contractor and License No.	Signature of Water Well Contract CEIVE	

MAY 0 8 2009


BY: OLWR

If well telescopes please sketch below and show depths.

Ground Level	
	es ENIA
	CASING 60
	-60
screen	90
_	CASENG 100
-	100
scree	110

Description of Formations Encountered	From	То
Description of Formations Encountered	0	10
MIXCIAI	10	38
Fine Sand	25	1/2
COARCSENE	10	
Finesand	60	90
	90	700
gravel	1/00	11

If more than one screen, show location of each on sketch

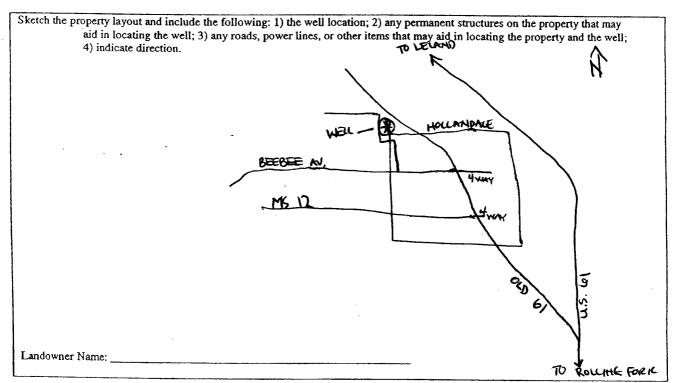

Signature of Water Well Contractor

STATE WELL REPORT

Part 2

Permit #: GOUY 3190

Driller: J. Wewcome 0-73

Pump Instal Mississippi Depart Office of Lacksco

Date completed: 4-17-09

Pump Installer's Completion Report
Mississippi Department of Environmental Quality
Office of Land and Water Resources
P.O. Box 10631

Jackson, MS 39289-0631 (601)961-5210 (601)354-6938 (fax)

This report should be prepared by the pump installer in detail and filed with the Department within 30 days of the installation of pump.

Well Owner Information	Well Location	
Owner Name 2000 Midae Planting Co	Latitude: 33.0 10'57" Longitude: 900 52' 13"	
Owner Name: Possum Ridge Planting Co. Mailing Address: % Po Lutten	Method of Lat/Long (circle one): Conventional Survey,	
134 curray no		
Holandel me zerue	USGS quad, Hand-held GPS, Survey-grade GPS 1/4 NE 1/4 Sec Twn GN Rng W	
Hollandale ms 38748 City State Zip Code		
Telaphasa Na. (14. 7. 9.35. 53. 6	Distance Direction Nearest Town	
Telephone No. (46) 822-5718	O Miles W of Hollandate	
Pump Type	Power Type	
Circle one	Circle one	
Air Lift Jet Submersible	Diesel Engine Gasoline Engine Natural Gas	
Bucket Piston Turbine	Electric Motor Hand Tractor PTO	
Centrifugal Rotary Flowing Well	Windmill Other (specify):	
Other (specify):	Horse Power Rating of Motor:	
Date Pump Installed: 4-17-09	Setting Depth: 70 feet	
Rated Pump Capacity: 2800 Gallons Per Minute	Number of Stages:	
Pump Test Data	Method of Measuring Water Level	
Date Well Tested:	Circle one	
Static Water Level (A):Feet Below Land Surface	Air Line Electric Measuring Line Steel Tape	
Pumping Water Level (B):Feet Below Land Surface	Other (specify):	
Drawdown [(B) - (A)]:Feet Below Land Surface	For flowing well, measured shut in head:feet	
Test Pumping Rate: Gallons Per Minute	Well yieldedGPM with a drawdown of	
Duration of Pump Test (minimum 4 hours):hours	feet afterhours of pumping	
V V V V V V V V V V V V V V V V V V V		
I HEREBY CERTIFY that the above statements are true to the best of my knowledge		
Print Name of Pump Installer and License No. (if applicable)	Signature of Pump Installer RECENT	

MAY 0 8 2009

BY: OLWR