

Washington  
 2000  
 7-30-79

MISSISSIPPI  
 BOARD OF WATER COMMISSIONERS  
 416 North State Street  
 Jackson, Mississippi 39201

WATER WELL DRILLERS LOG

July 30 19 79 Bruce Berryman Washington  
 date well completed firm name county well located

LANDOWNER: Rusty Willis Rt. 1. Box 239 Hollandale. MS 38748 (mailing address)	description of formations encountered	from	to
	Clay	0	20
	Sand	20	60
	Sand & Gravel	60	140
	Clay	140	160
	Sand	160	320
	Shale	320	380
	Sand & Shale	380	440
	Shale & Str. sand	440	620
	Shale & rocks	620	640
	Fine sand	640	660
	Sand & str. shale	660	700
	Shale	700	740
	Sand	740	800
	Shale	800	830

WELL LOCATION:

sec. 32 T 15 N R 7 W  
 10 miles S.W. of HOLLANDALE  
 (distance) (direction) (nearest town)

WELL PURPOSE: Home  
 (home, irrigation, municipal, industrial)

WELL COMPLETION DATA:

- (1) diameter (inches) 4" x 2"
- (2) total depth (feet) 808'
- (3) static water level (feet) 21' below top of ground.
- (4) casing 4" blk. - 126'  
 2" galy. - 661'  
 (material) (depth)
- (size) If telescope see back.
- (5) screen 20' length, 641' depth to top  
 .010 stainless steel  
 (size) (material)
- (6) pump 1/2 HP, 35 yield gpm
- Electric (type power)
- (7) electric log No (yes or no)  
 (organization running log)
- (8) how well bottom plugged B.P.V.

DEPT. OF NATURAL RESOURCES  
 BUREAU OF LAND & WATER RESOURCES


DEC 14 1979

RECEIVED

DRILLERS REMARKS:

If well telescopes please sketch and show depths.

GROUND LEVEL

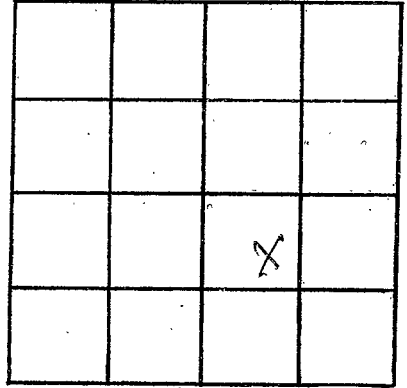

SECTION 32

Please indicate well location X.

ADDITIONAL INFORMATION

If more than one screen, show locations of each on sketch.