

should be in P grid

C17330

WASHINGTON  
MISSISSIPPI  
4-8-74

MISSISSIPPI  
BOARD OF WATER COMMISSIONERS  
416 North State Street  
Jackson, Mississippi 39201


CODED

WATER WELL DRILLERS LOG

April 8, 1974 Singer-Layne Central Div. Washington  
date well completed firm name county well located

LANDOWNER:	description of formations encountered	from	to
Thomas Hollingsworth & Co. Hollandale, Mississippi (mailing address)			
	Fine Sand	15	32
	Coarse Sand	32	55
	Pea Gravel	55	65
	Sand Gravel	65	85
	Rock	85	112
<b>WELL LOCATION:</b> sec. 3 T 15 N R 6 E 2 miles East of Hollandale (distance) (direction) (nearest town)			
<b>WELL PURPOSE:</b> Irrigation (home, irrigation, municipal, industrial)			
<b>WELL COMPLETION DATA:</b>			
(1) diameter (inches) 16"			
(2) total depth (feet) 112'			
(3) static water level (feet) 14	below above top of ground.		
(4) casing Steel 62'	(material) (depth)		
16"	If telescope see back.		
(size)			
(5) screen 50'	112'		
(length)	(depth to top)		
16"	Armco Iron		
(size)	(material)		
(6) pump	(HP) (yield gpm)		
Purchaser's own pumping equipment.			
(type power) to be installed			
(7) electric log No	(yes or no)		
(organization running log)			
(8) how well bottom plugged	Plate		
DRILLERS REMARKS:			


CODED

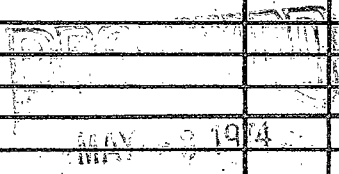

MISSISSIPPI BOARD OF WATER COMMISSIONERS

If well telescopes please sketch and show depths.

GROUND LEVEL

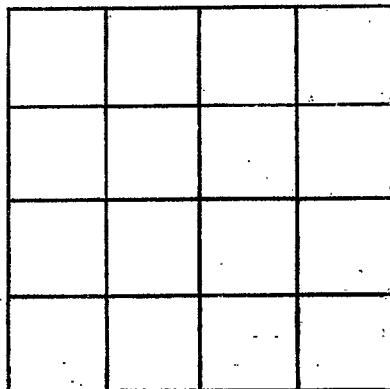

SECTION \_\_\_\_\_

Please indicate well location X.

ADDITIONAL INFORMATION

If more than one screen,  
show locations of each on sketch.