

P 31

9-23-57

WATER WELL DRILLERS LOG

10/1/65
2491

Date: Sept. 23, 1957, Driller: Layne-Central Company County Washington

(Name)

Oil Mill

(1) Owner of Land: Hollandale Cotton
(Name)

Hollandale, Mississippi
(Address)

(2) Location: 1/4, 1/4, Sec. 6 T R

 miles of Hollandale
(distance) (direction) (Nearest Town)

(3) Topography: flat
(Hilly) (Flat) (Level)

(4) Purpose of Well: industrial
(Domestic Irrigation
Municipal, Industrial, Other)

Description & Color of Materials
Sand, Clay, Red Clay, Shell, etc.

Thick-
ness
Feet

Depth
Feet

Top sandy soil	5	5
Blue clay	21	26
Fine brown sand	7	33
Coarse sand	9	42
Coarse sand	30	72
Coarse sand & pea rock	10	82
Sand & gravel	20	102
Sand & gravel	7'6"	109'6"

Information upon completion of well:

- (1) Diameter 12x8 inches.
- (2) Total Depth 109'6" feet.
- (3) Water Level 19'3" feet below top of ground.
- (4) Cased to 77', Size 12"
2' of 12" x 8" swage
- (5) Screen: Size 8", Length 30'
- (6) Were any formations sealed against pollution?
 yes, no no.


If YES depth of formation

Why

Drillers Remarks:

770 GPM.

Electric power.

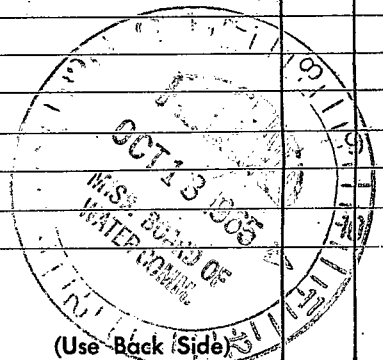

Well No.

(Use Back Side)

